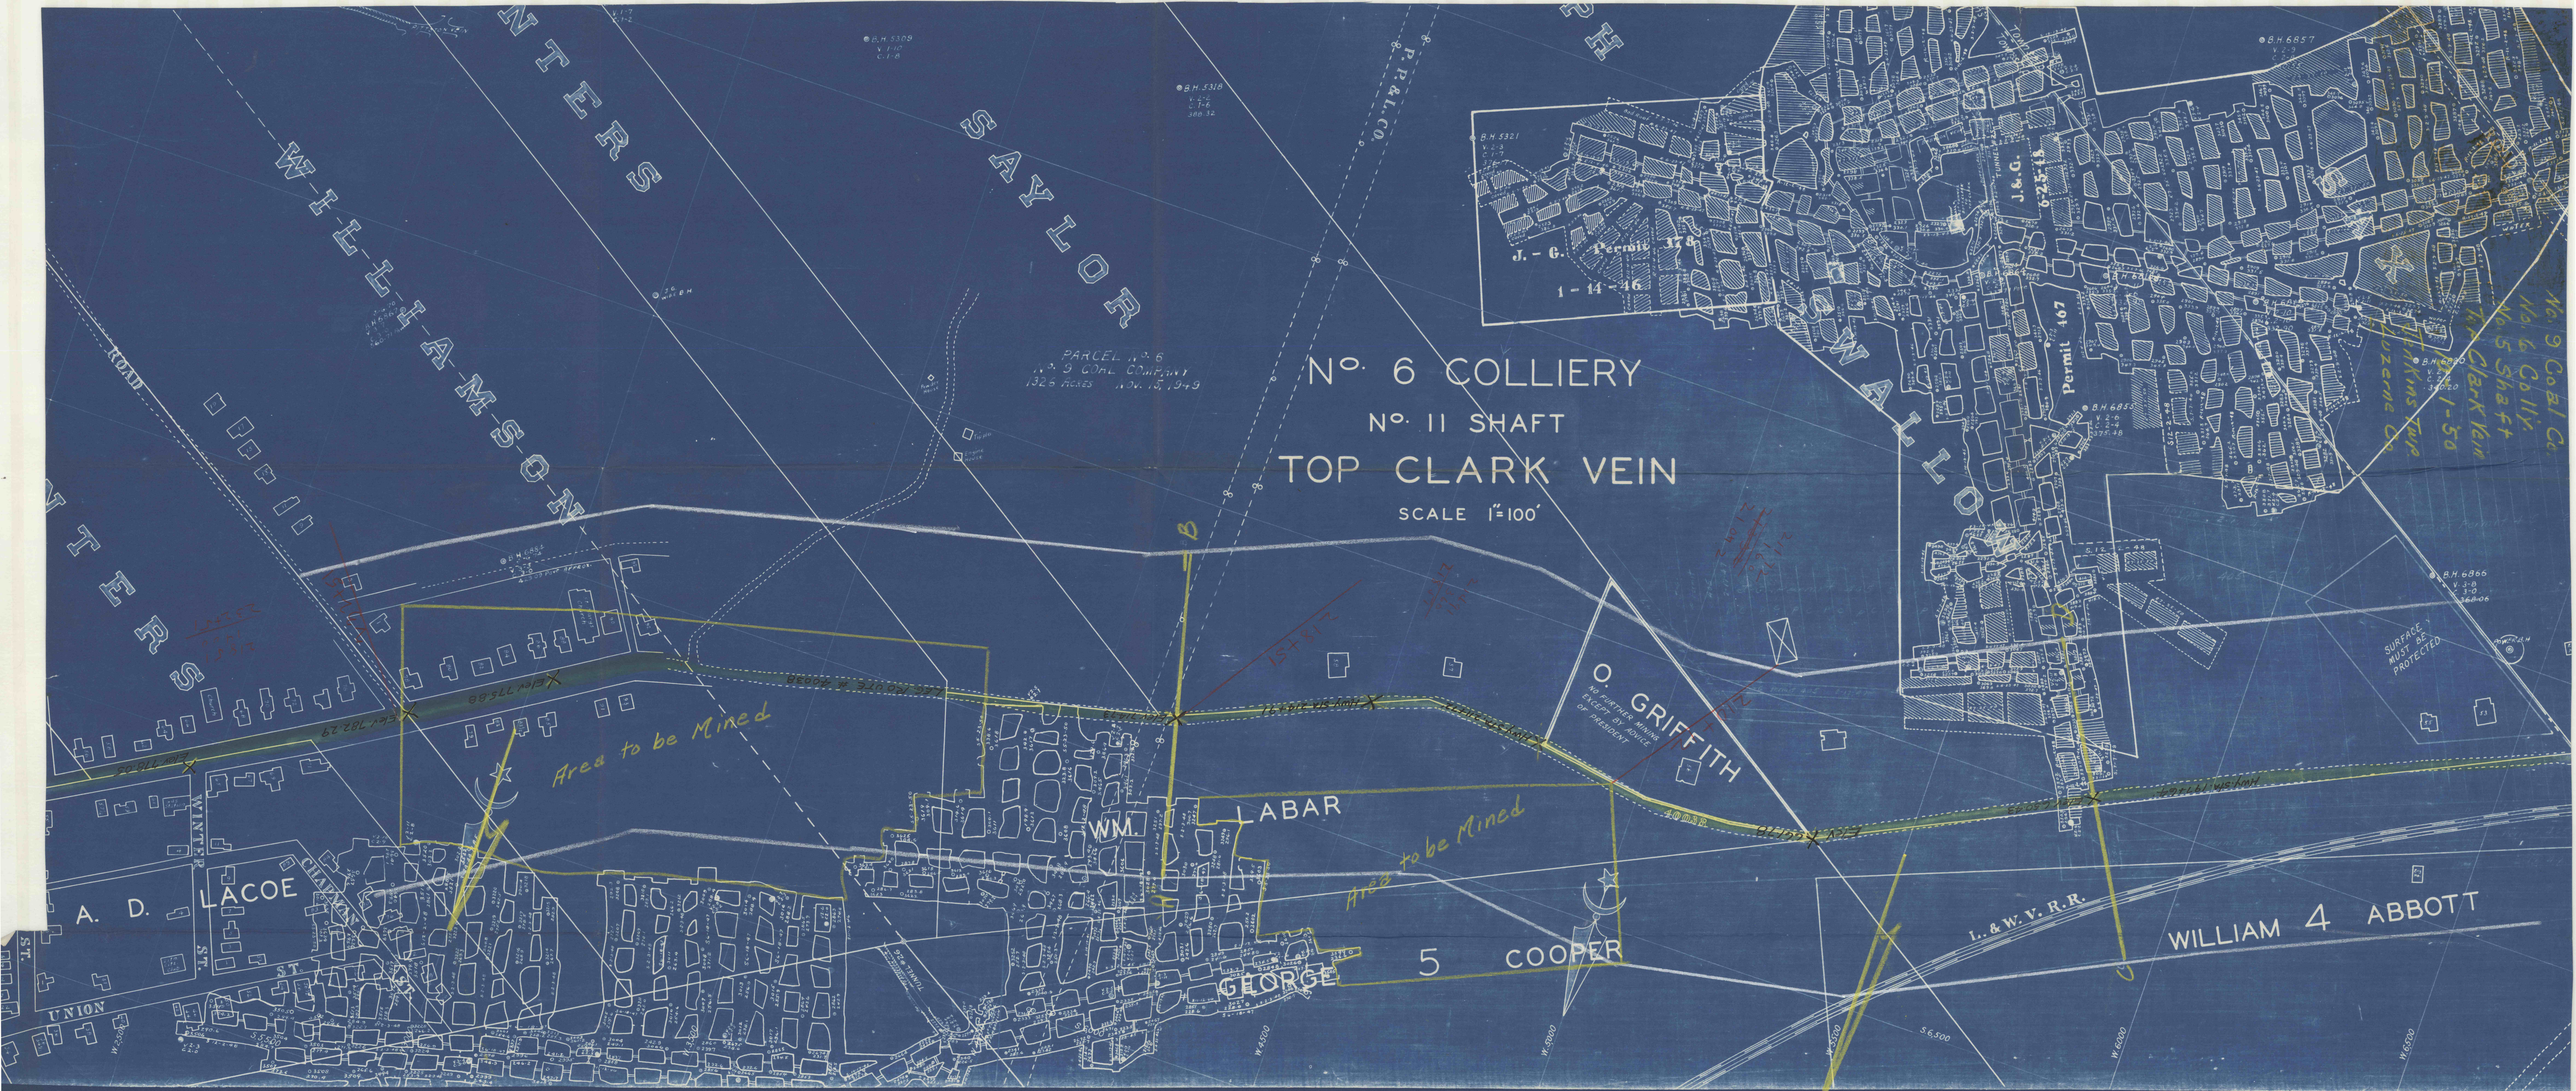
No. 6 COLLIERY
No. 11 SHAFT
TOP CLARK VEIN
SCALE 1"=100'
WATERS
WILLIAMSON
SAYLOR
PARCEL No. 6
W. P. Coal Company
132.6 Acres Nov. 18, 1949
J. - G. Permit 378
1 - 14 - 46
J. & G. 625-18
Permit 407
Area to be Mined
Area to be Mined
WM. LABAR
O GRIFFITH
No further mining except by joint consent of President
A. D. LACOE
5 COOPER
GEORGE
WILLIAM 4 ABBOTT
L. & W. V. R.R.
SURFACE MUST BE PROTECTED
No. 9 Coal Co.
No. 6 Colly.
No. 5 Shaft
Top Clark Vein
1-50
UNION ST.
WATERS ST.
OLIVE ST.
ROAD