



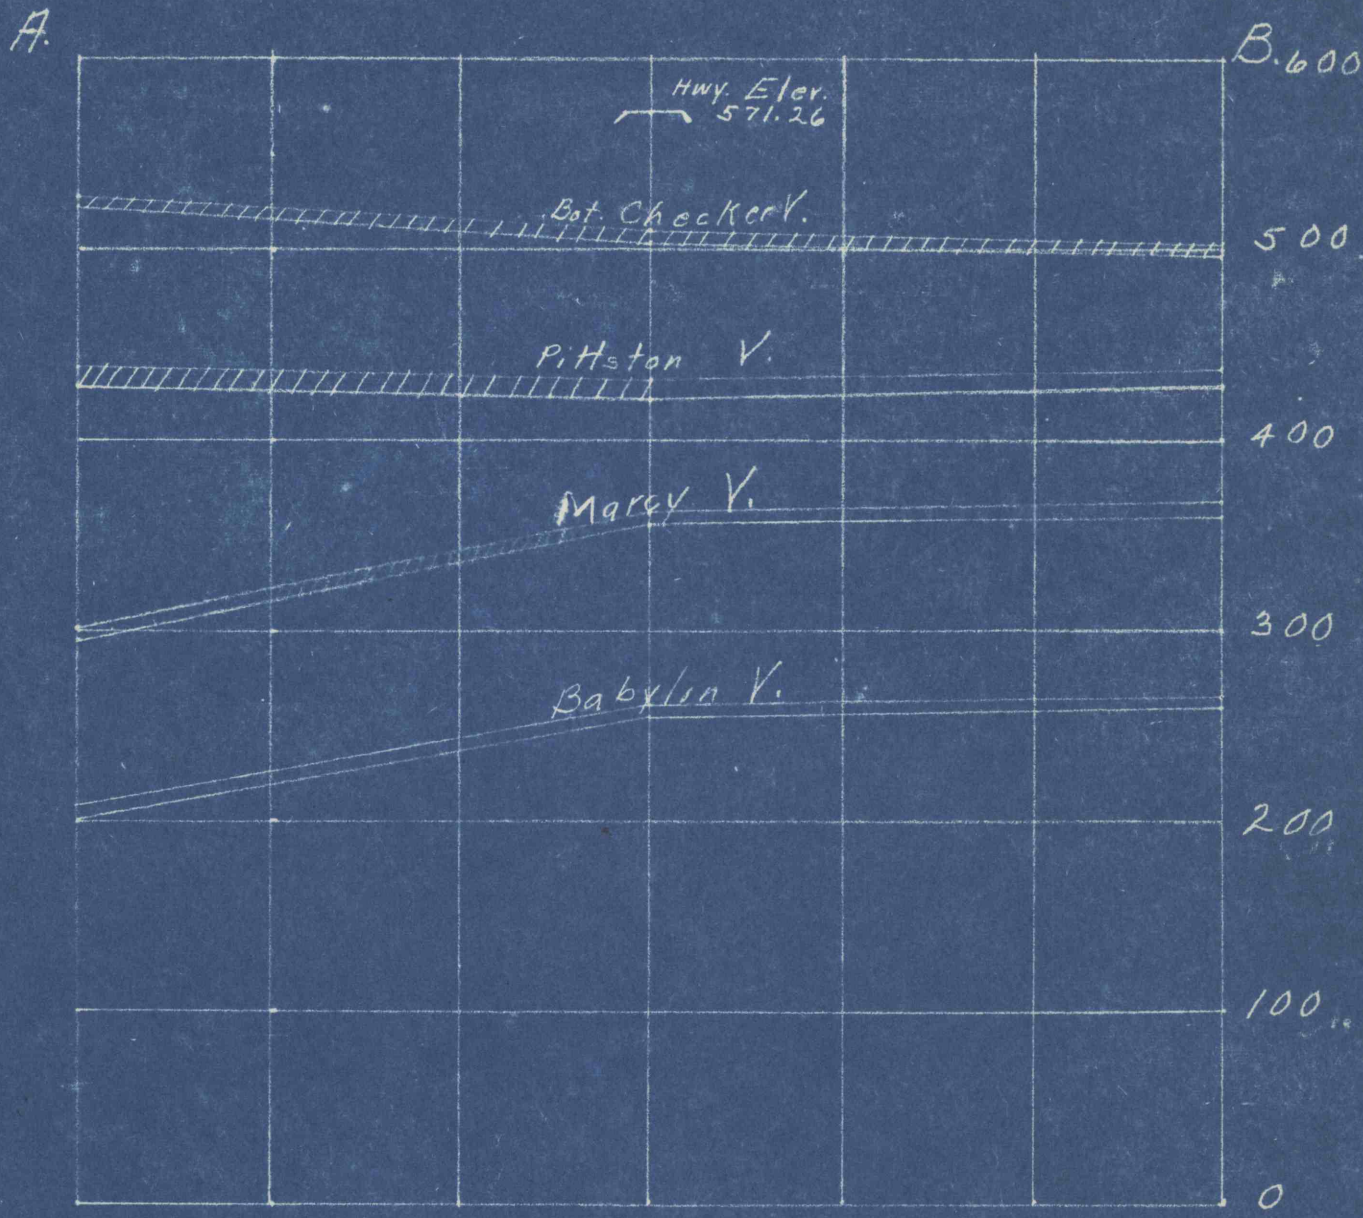

Section A - B.

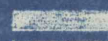

NO. 14 COLLIERY
 No. 14 Drifts - Babylon Vein
 Scale 1" - 100'

Cross section of Babylon Vein
 underlying Leg. Route #40038
 in Plains Twp., Luz. Co., Pa.

-  Virgin coal
-  First mining
-  Complete mining.