


23

Pg. 15

L

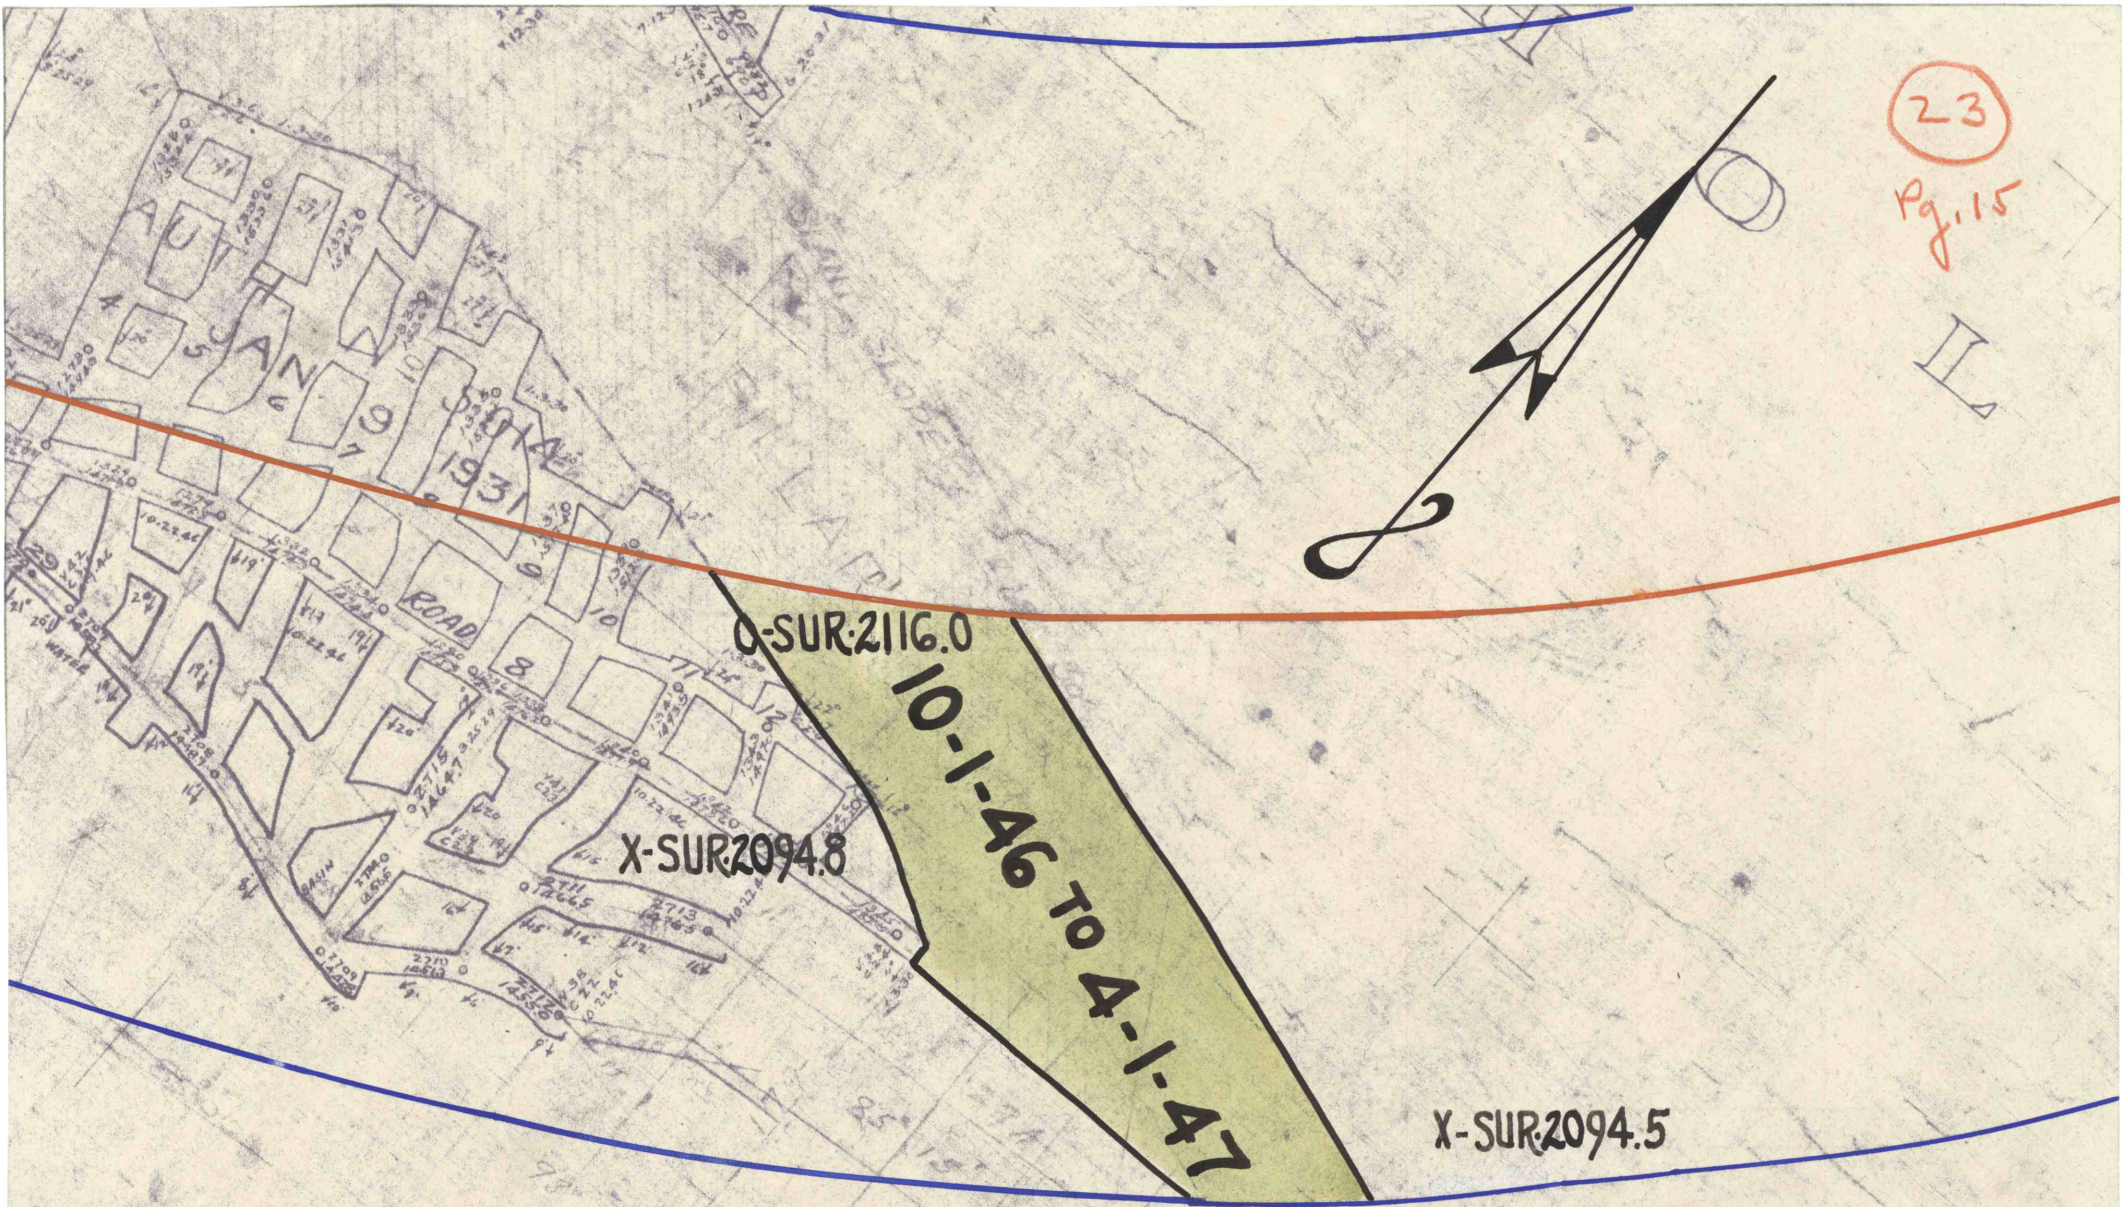

ROUTE N° 40038  
PLAINS TOWNSHIP  
PROSPECT COLLIERY  
LEHIGH VALLEY COAL COMPANY  
TOP FIVE FOOT VEIN  
SCALE 1" = 100'  
DATUM 1500' BELOW TIDE