


22
Pg 15

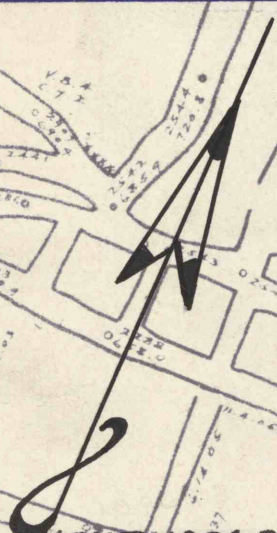

X-SUR. 1096.3

X-SUR. 1076.0

O-SUR. 1073.5

O-SUR. 1061.8

10-1-46 TO 4-1-47

O-SUR. 1065.6

10-1-46
4-1-47

X-SUR. 1059.8

ROUTE No 40038

WILKES-BARRE CITY & PLAINS TOWNSHIP

PROSPECT COLLIERY

LEHIGH VALLEY COAL COMPANY

HILLMAN VEIN

SCALE 1" = 100'

DATUM, 500' BELOW TIDE