


X SUR. 1071.2

4-1-47 to 10-1-47

X SUR. 1074.6

X SUR. 1137.3

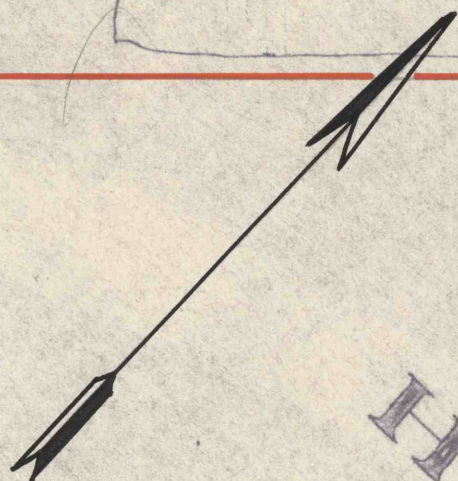

HUB

ROUTE N° 40038  
WILKES-BARRE CITY  
PROSPECT COLLIERY  
LEHIGH VALLEY COAL COMPANY  
ABBOTT VEIN  
SCALE 1"=100'  
DATUM 500' BELOW TIDE

BALTIMORE  
"C" BED