





SECTION A-B

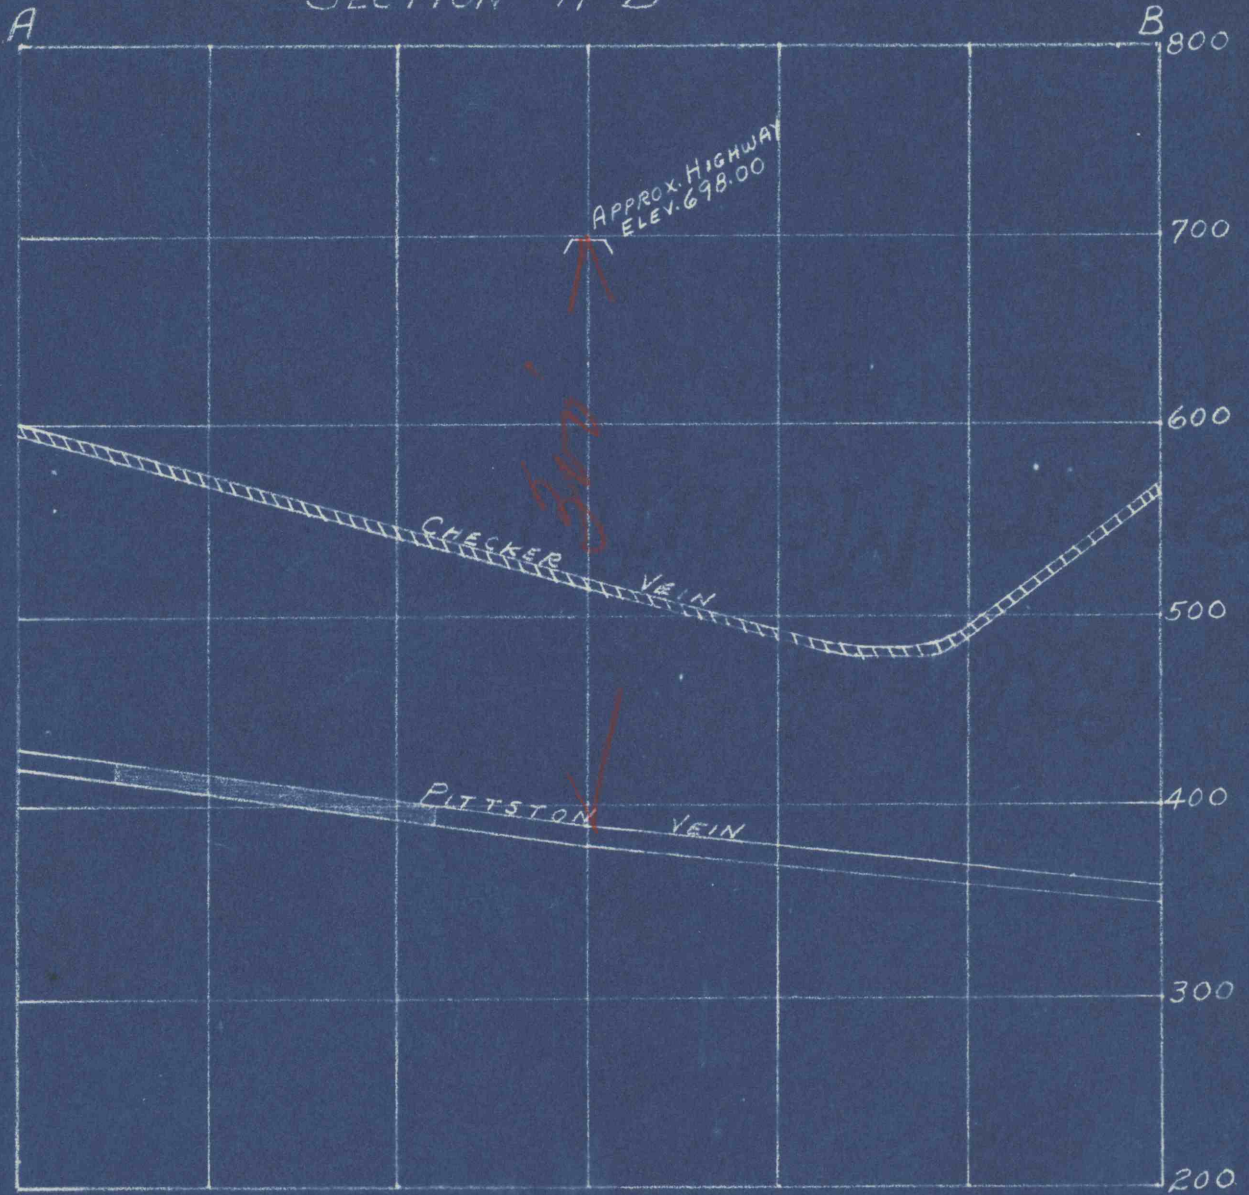

EWEN COLLIERY
No. 7 Shaft - Pittston Vein
Scale 1" = 100'

Cross section of Pittston Vein
underlying Leg. Route #40038,
Jenkins Twp., Luzerne Co., Pa.

-  Virgin coal
-  First mined
-  Mining completed