



SECTION "A-B"

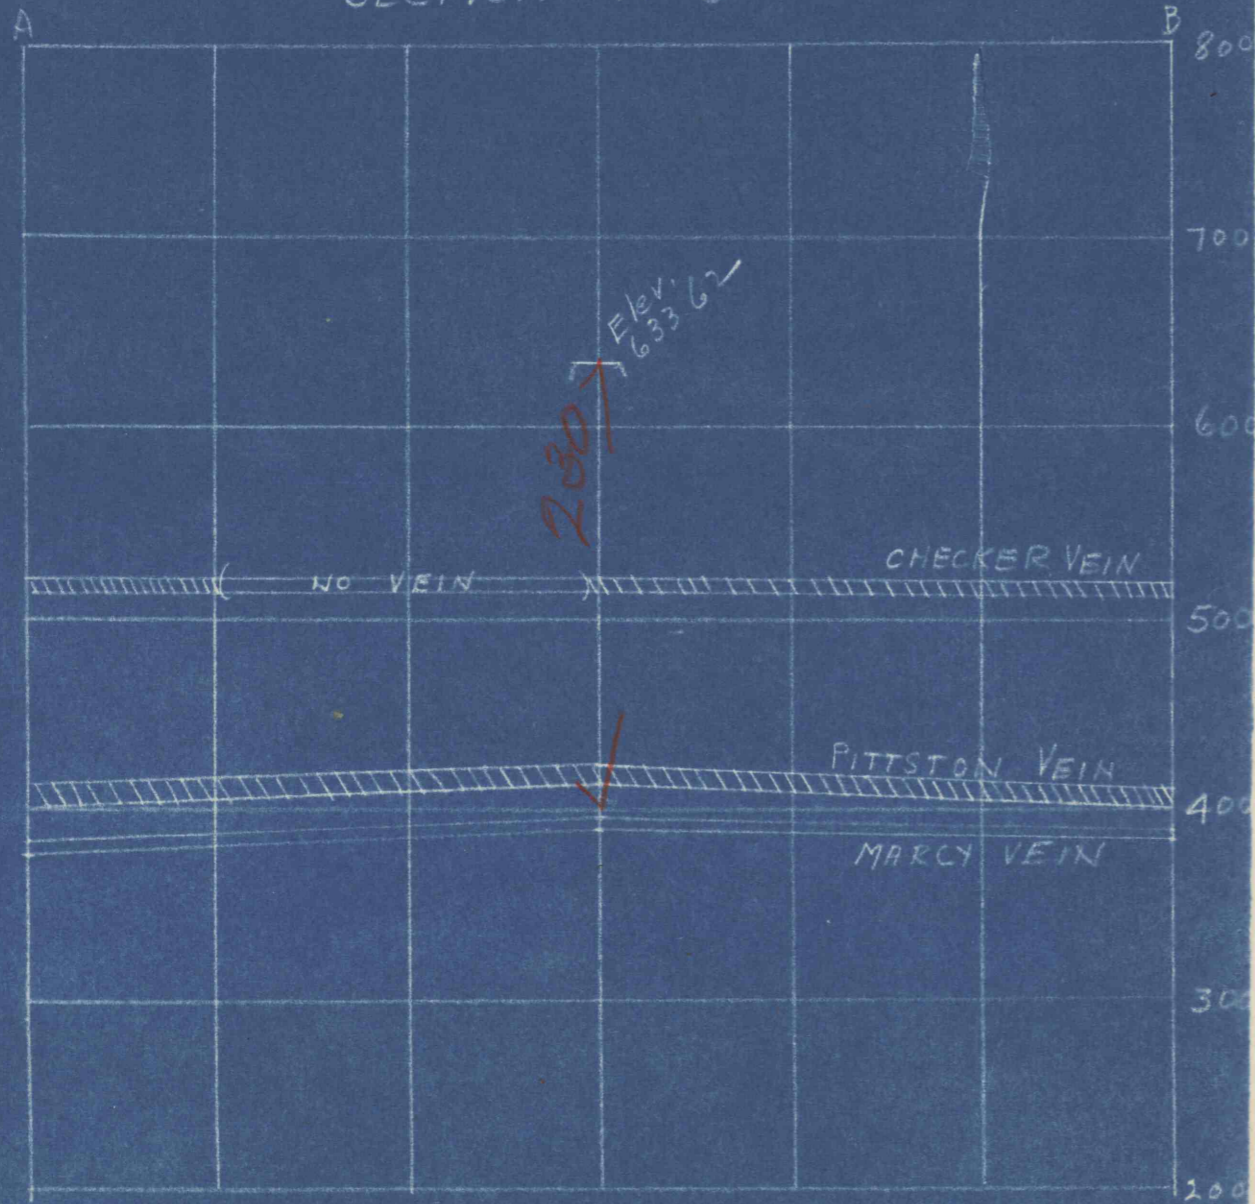

SECTION C-D

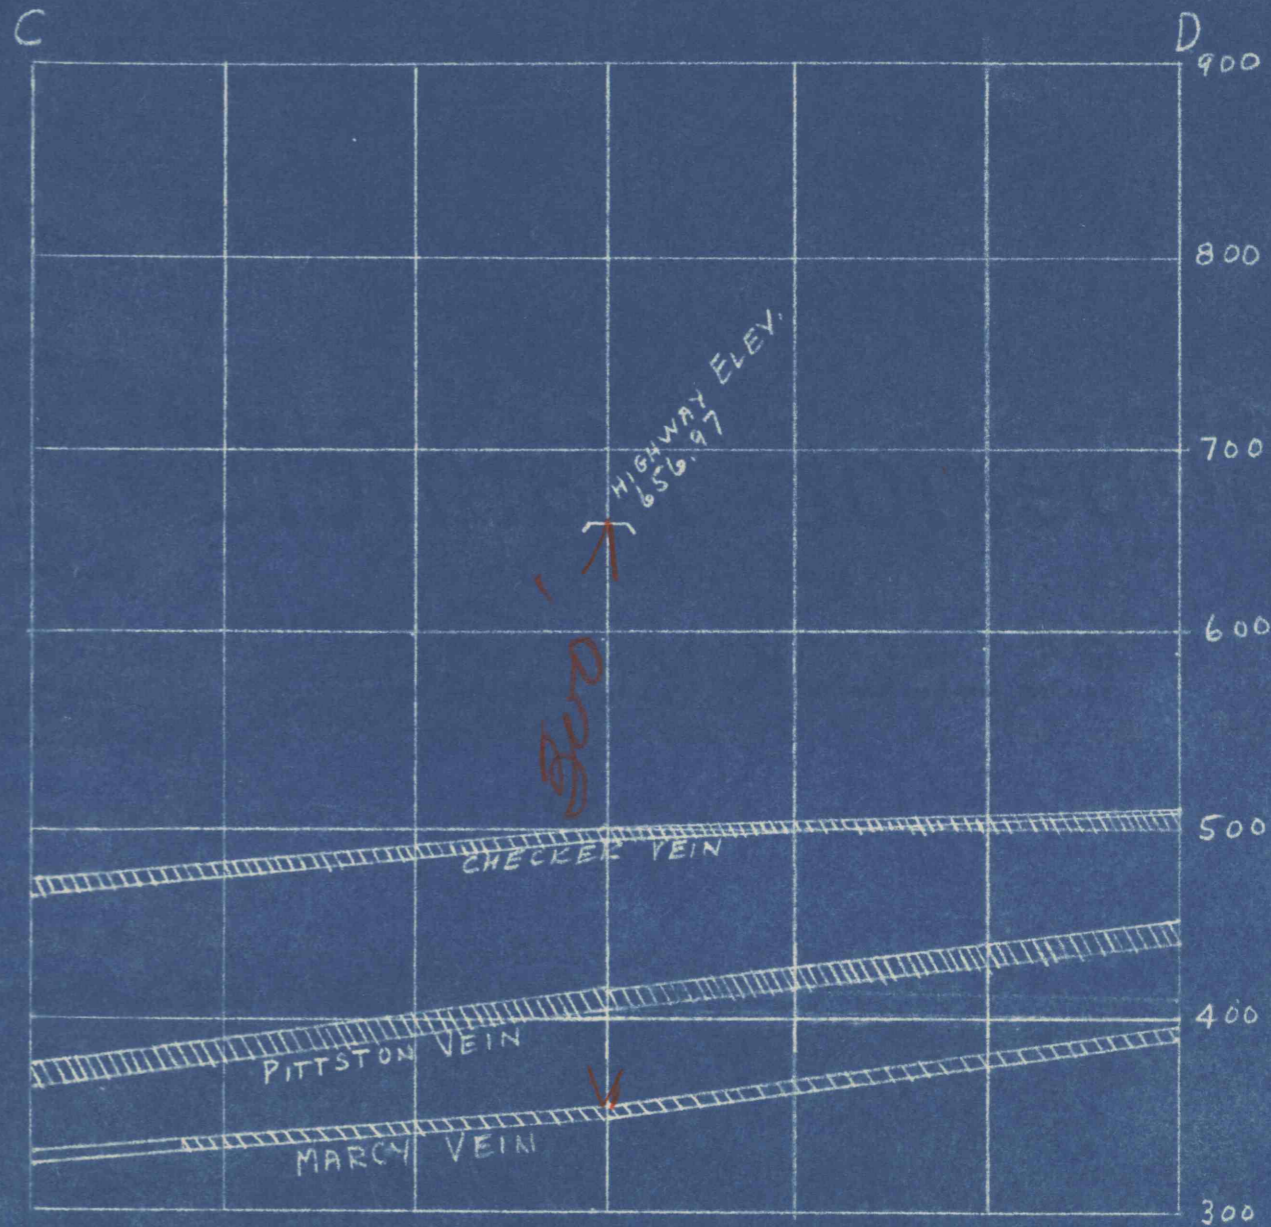

EWEN COLLIERY
 NO. 7 SHAFT - MARCY VEIN
 Scale 1" = 100'

Cross sections underlying Leg.
 Routes #40038 and 40044 in
 Jenkins Twp., Luzerne County, Pa.
 & PITTSTON CITY

▭ First Mined.
 ▨ Mining Completed.