





SECTION A-B

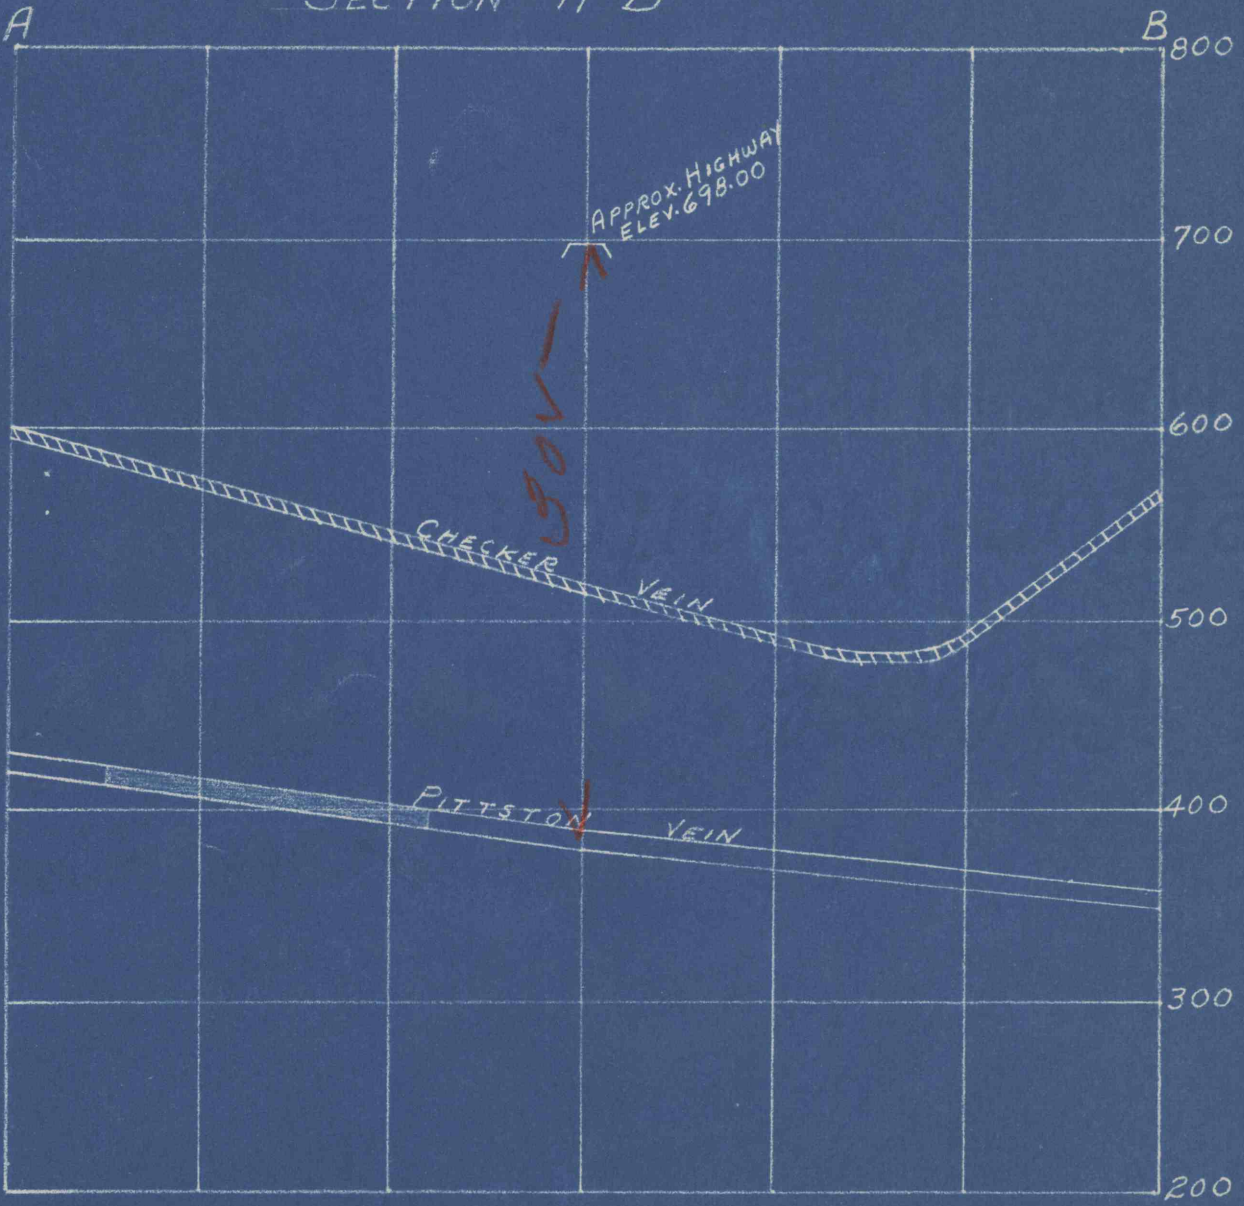

EWEN COLLIERY
 No. 7 Shaft - Pittston Vein
 Scale 1" - 100'

Cross section of Pittston Vein
 underlying Leg. Route #40038,
 Jenkins Twp., Luzerne Co., Pa.

-  Virgin coal
-  First mined
-  Mining completed