



SECTION "A-B"

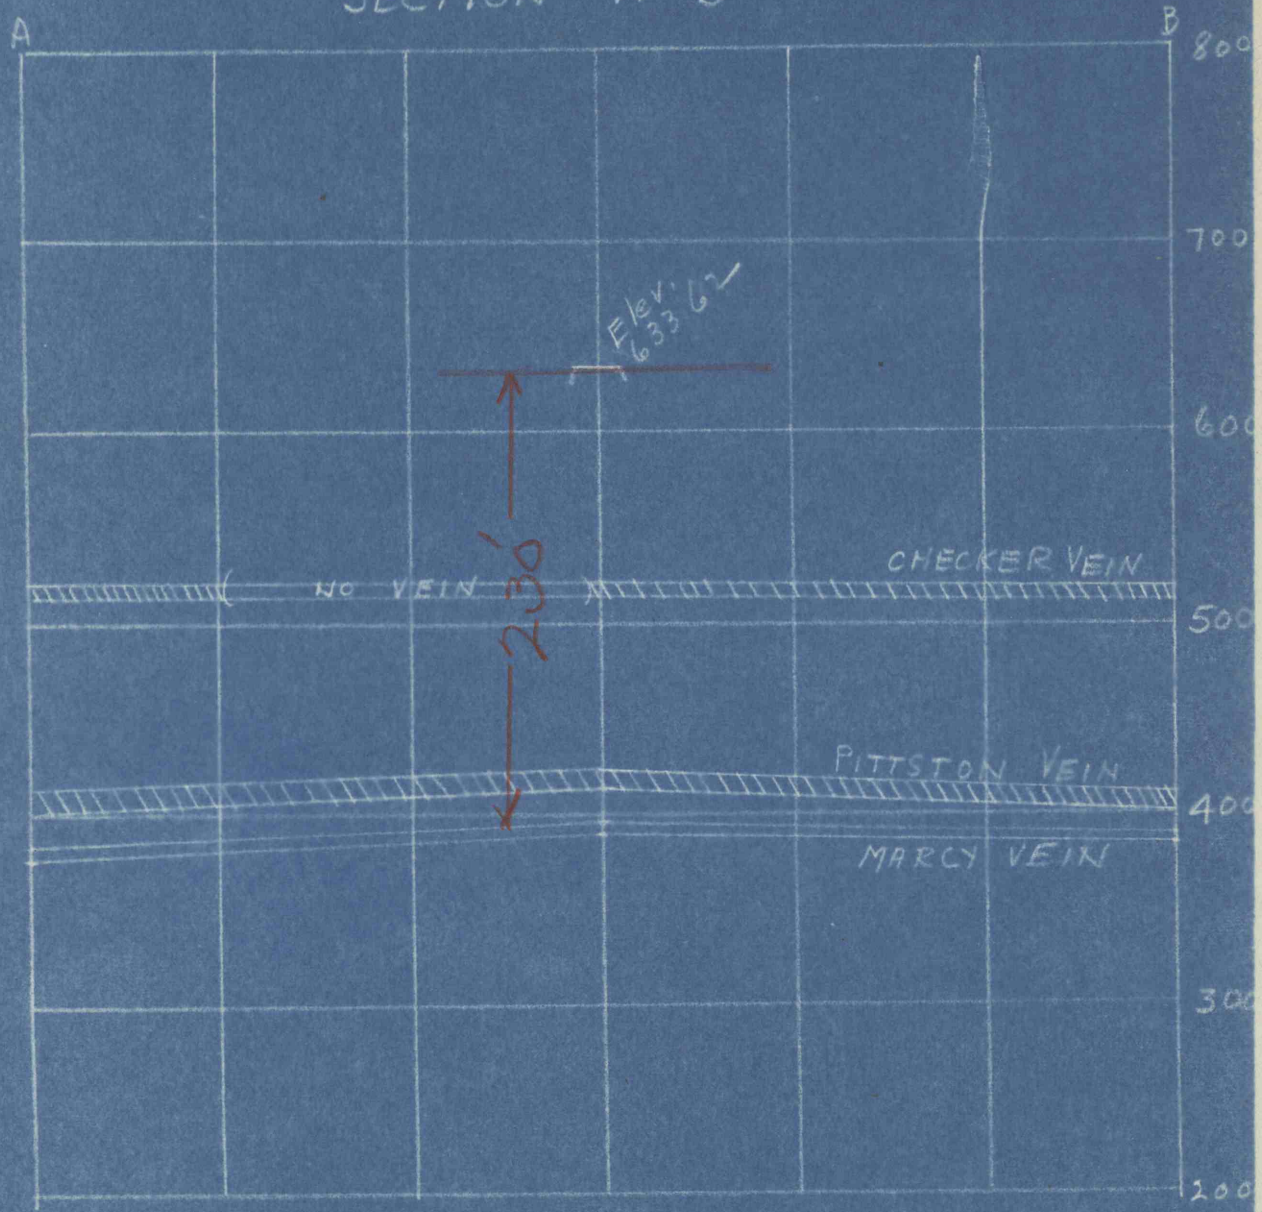

SECTION C-D

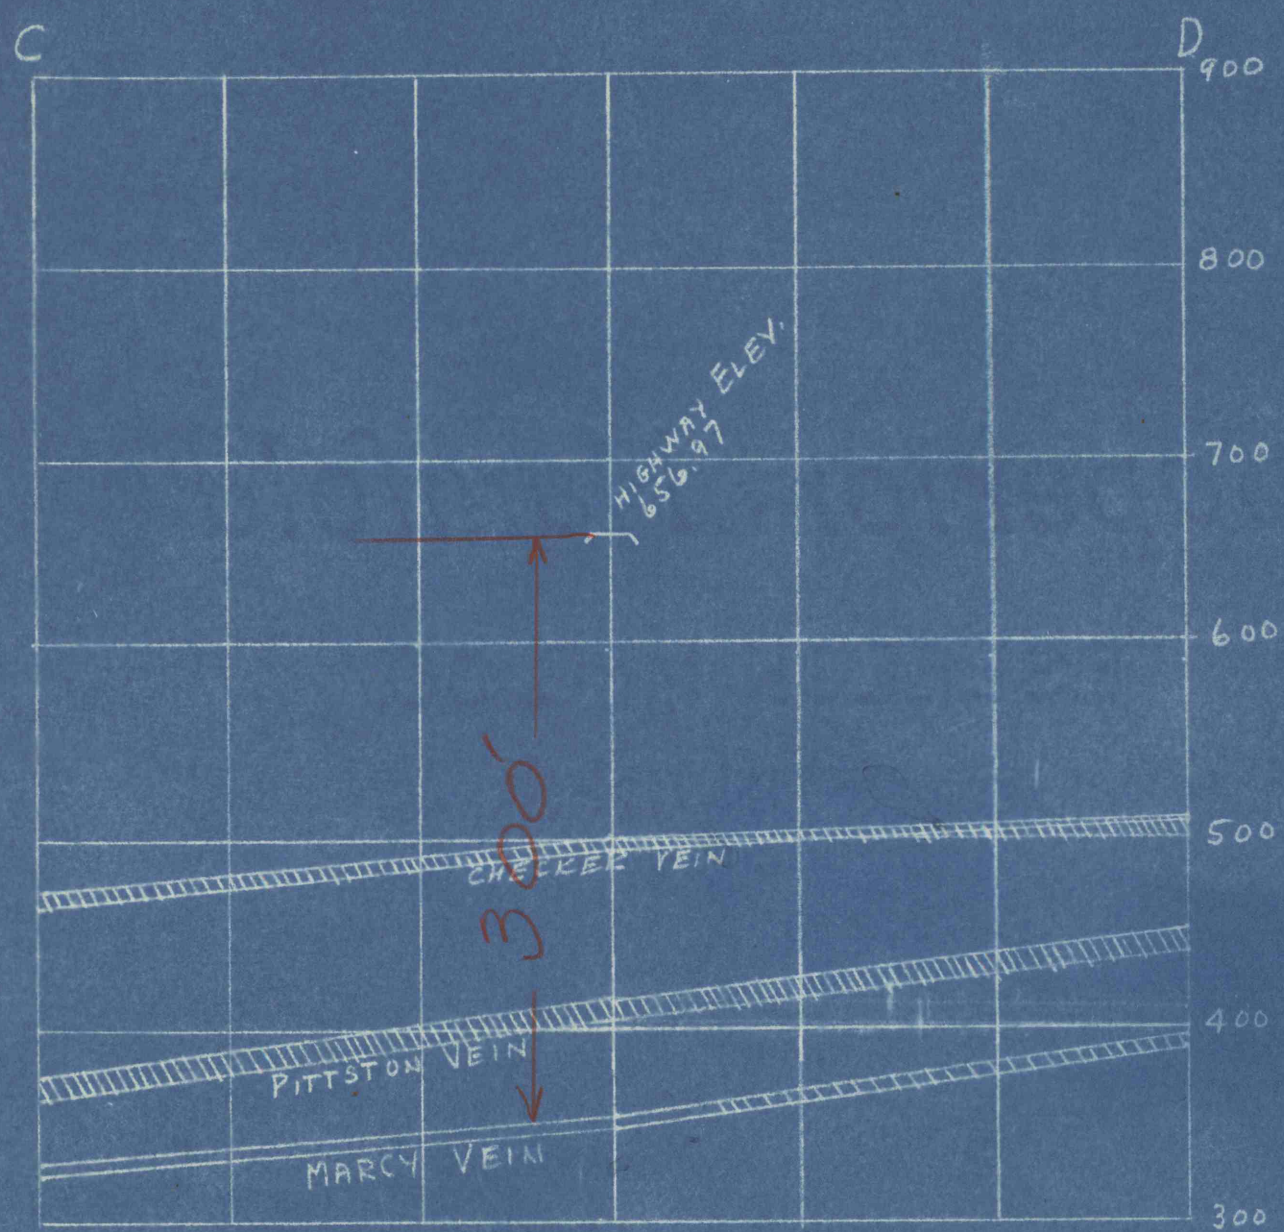

EWEN COLLIERY  
 NO. 7 SHAFT - MARCY VEIN  
 Scale 1" = 100'

Gross sections underlying Leg.  
 Routes #40038 and  #5 in  
 Jenkins Twp., Luzerne County, Pa.  
 & Pittston City

▭ First Mined.  
 ▨ Mining Completed.