



SECTION "A-B"

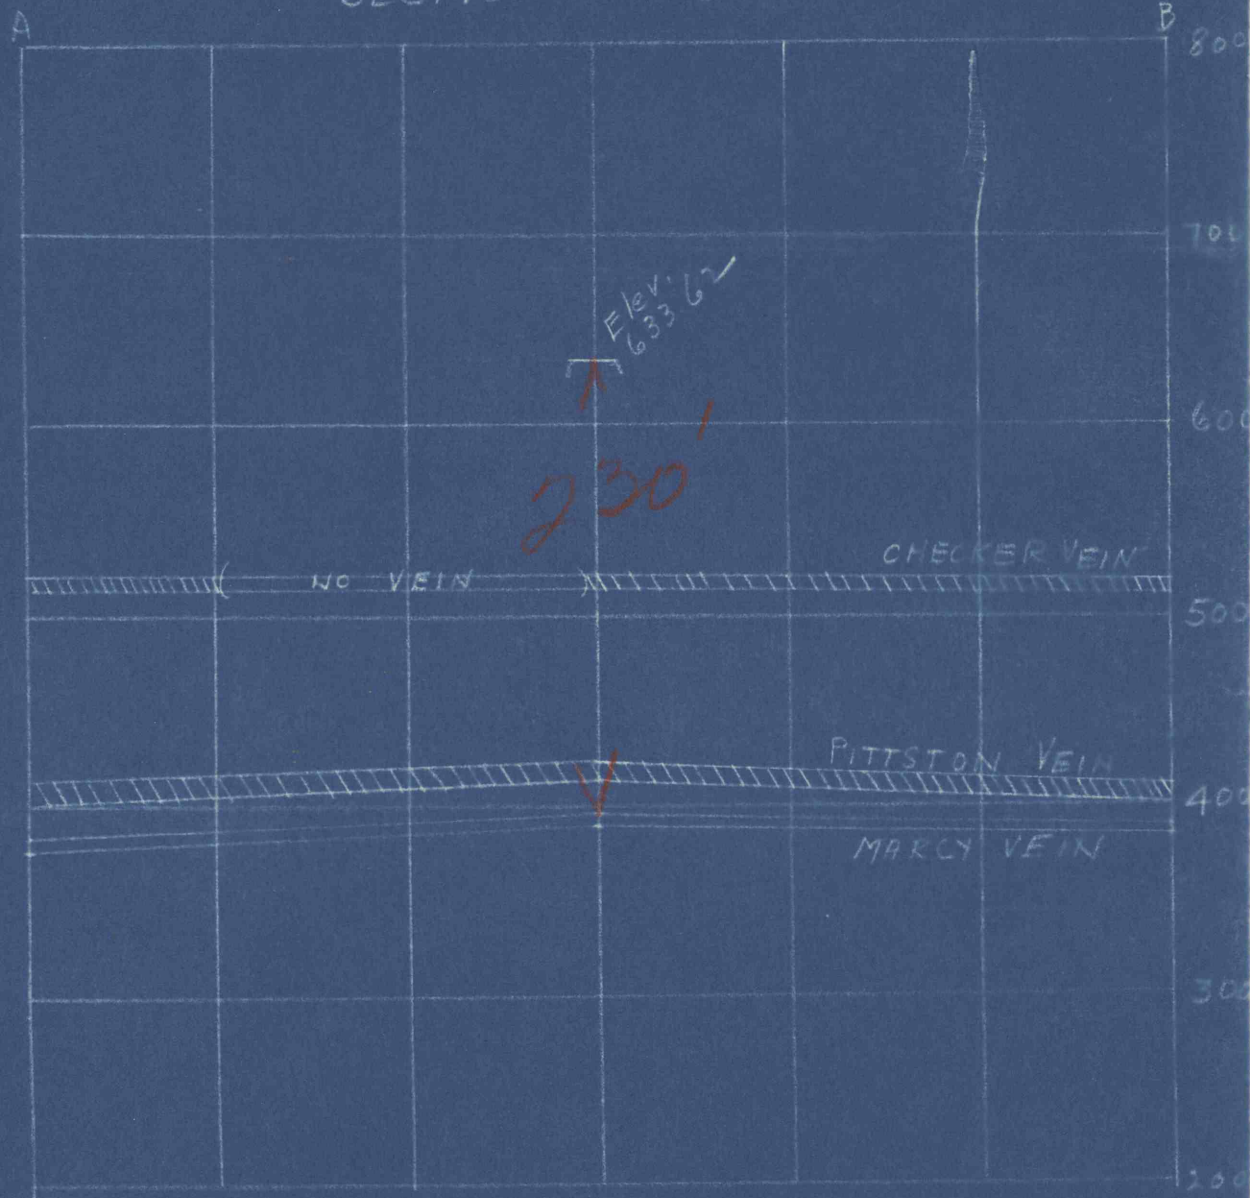



SECTION C-D

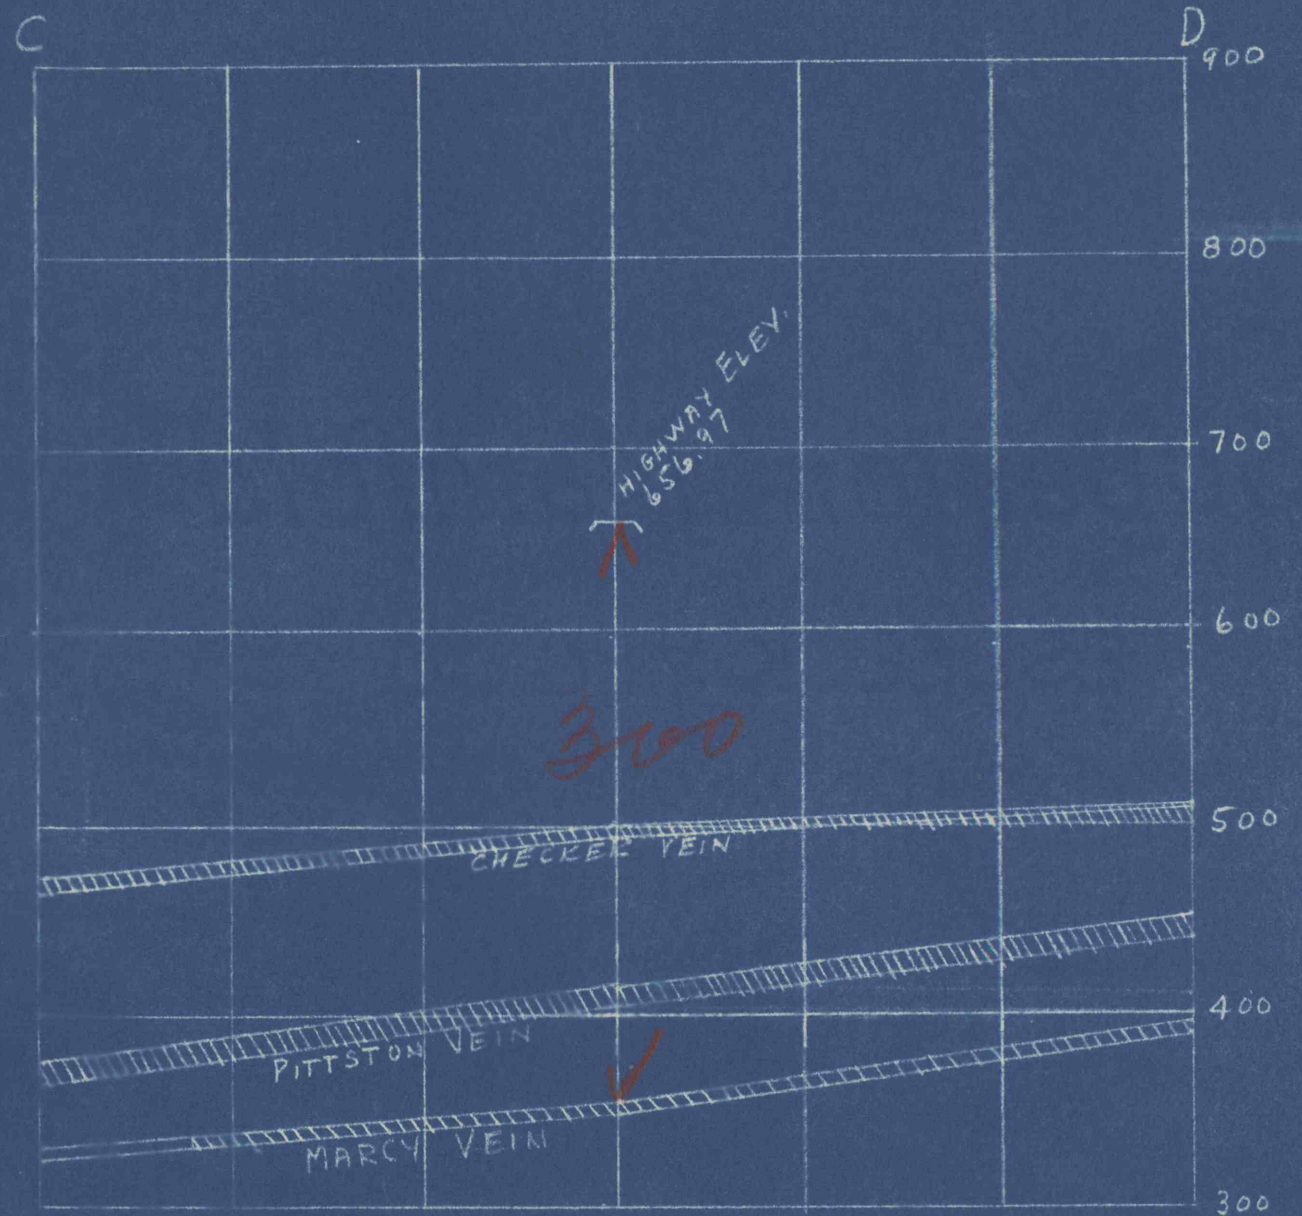

EWEN COLLIERY
 NO. 7 SHAFT - MARCY VEIN
 Scale 1" = 100'

Cross sections underlying Leg.
 Route #40038 in Pittston City &
 Jenkins Twp., Luzerne County, Pa.

-  First Mined.
-  Mining Completed.