


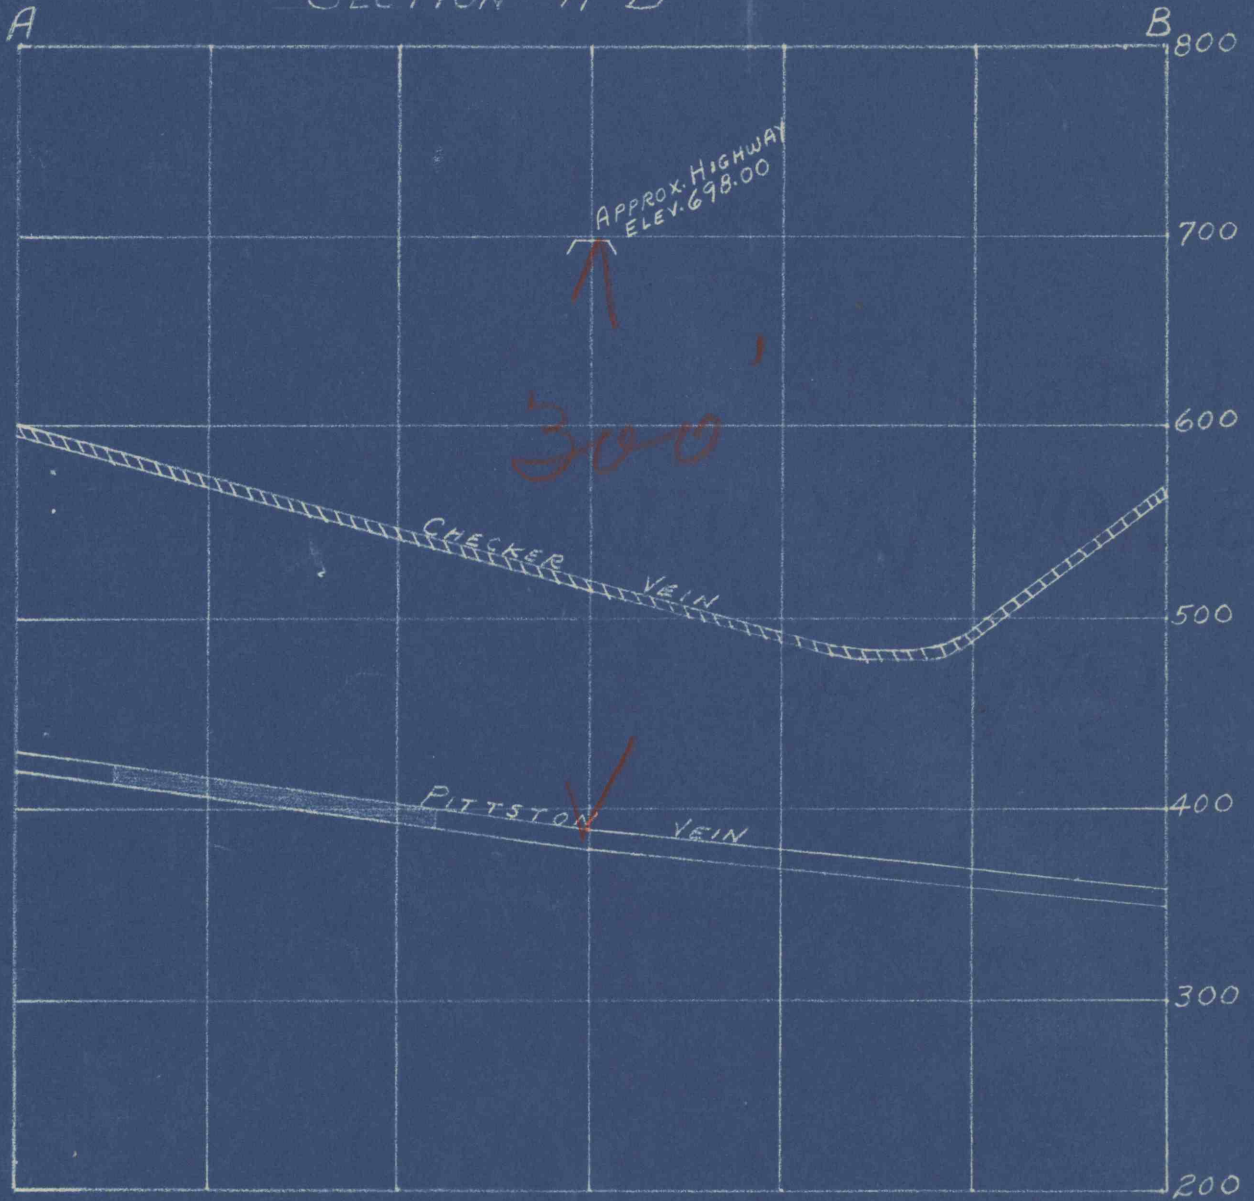


SECTION A-B



EWEN COLLIERY  
 No. 7 Shaft - Pittston Vein  
 Scale 1" = 100'

Cross section of Pittston Vein  
 underlying Leg. Route #40038,  
 Jenkins Twp., Luzerne Co., Pa.

-  Virgin coal
-  First mined
-  Mining completed