


ROUTE 40038 - STA. 310+65
PITTSTON CITY. AUG. 2, 1947

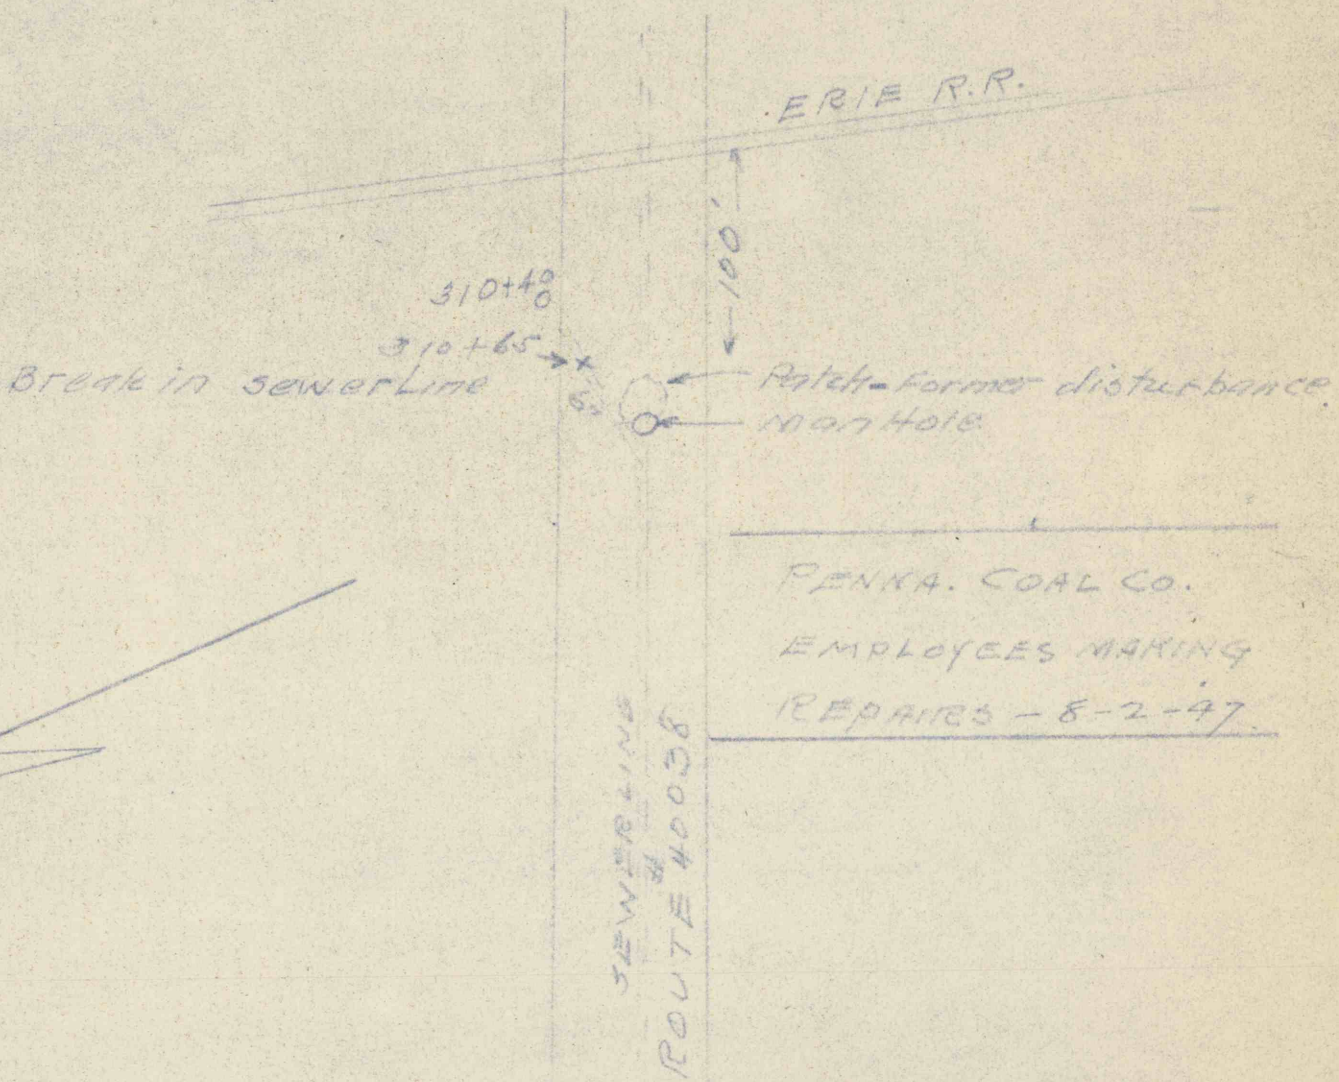

PENNA. COAL CO.
EMPLOYEES MAKING
REPAIRS - 8-2-47.

A.E.Y.