


112

ROUTE 40038 - STA. 310+65
PITTSTON CITY. AUG. 2, 1947

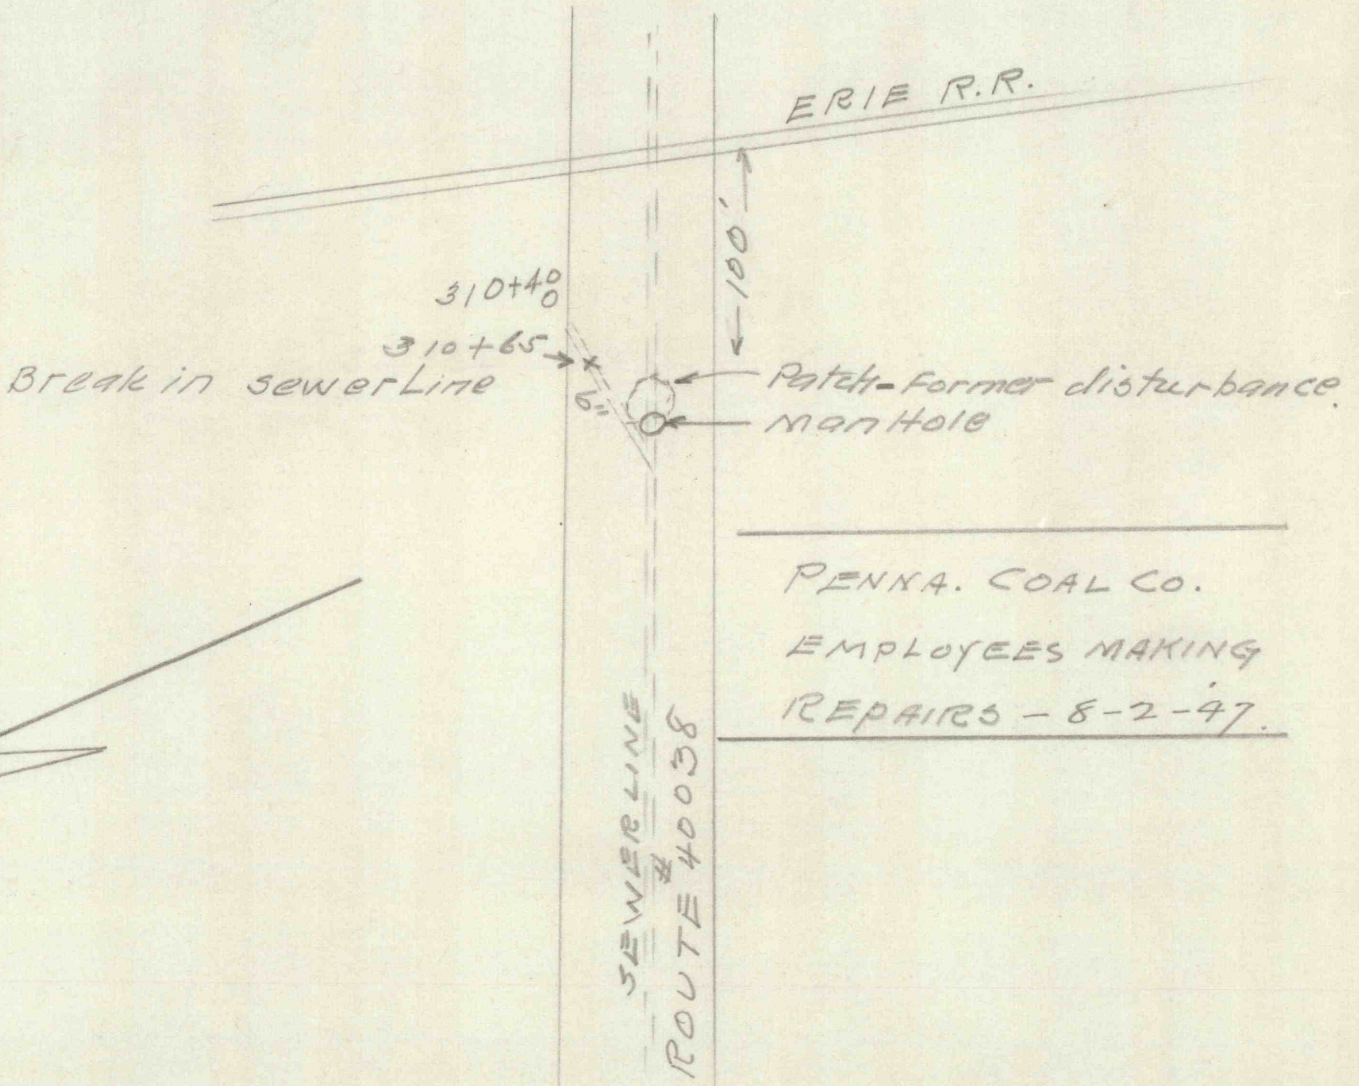

A.E.Y.