




50403
 50000

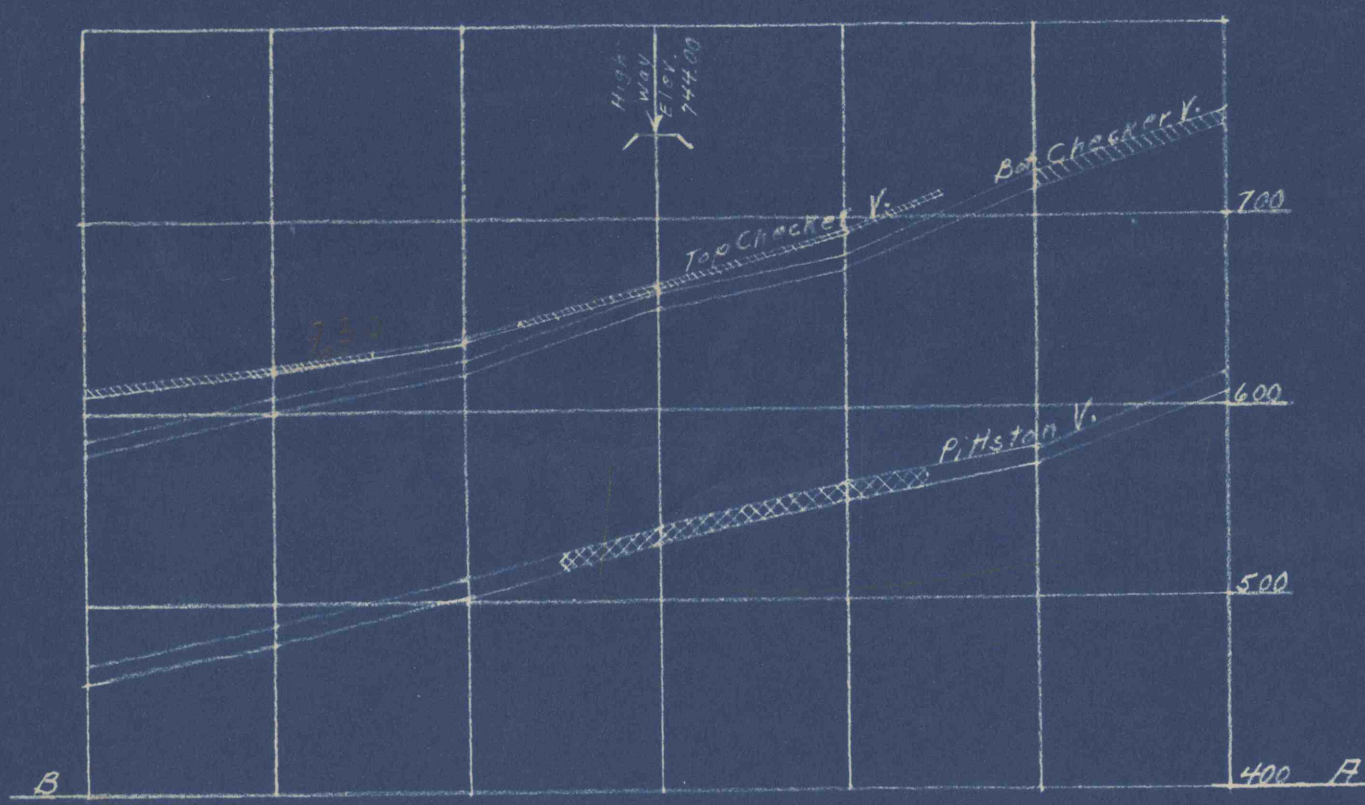

M. J. ...

100000

NO. 6 COLLIERY
VOLPE COAL COMPANY
 Cross section of Legislative
 Route No. 40038 showing Top Chec-
 ker, Bot. Checker and Pittston
 Veins, Jenkins Twp.
 Scale 1" = 100' 1-11-38.

 Mining completed.
 Rock filled.