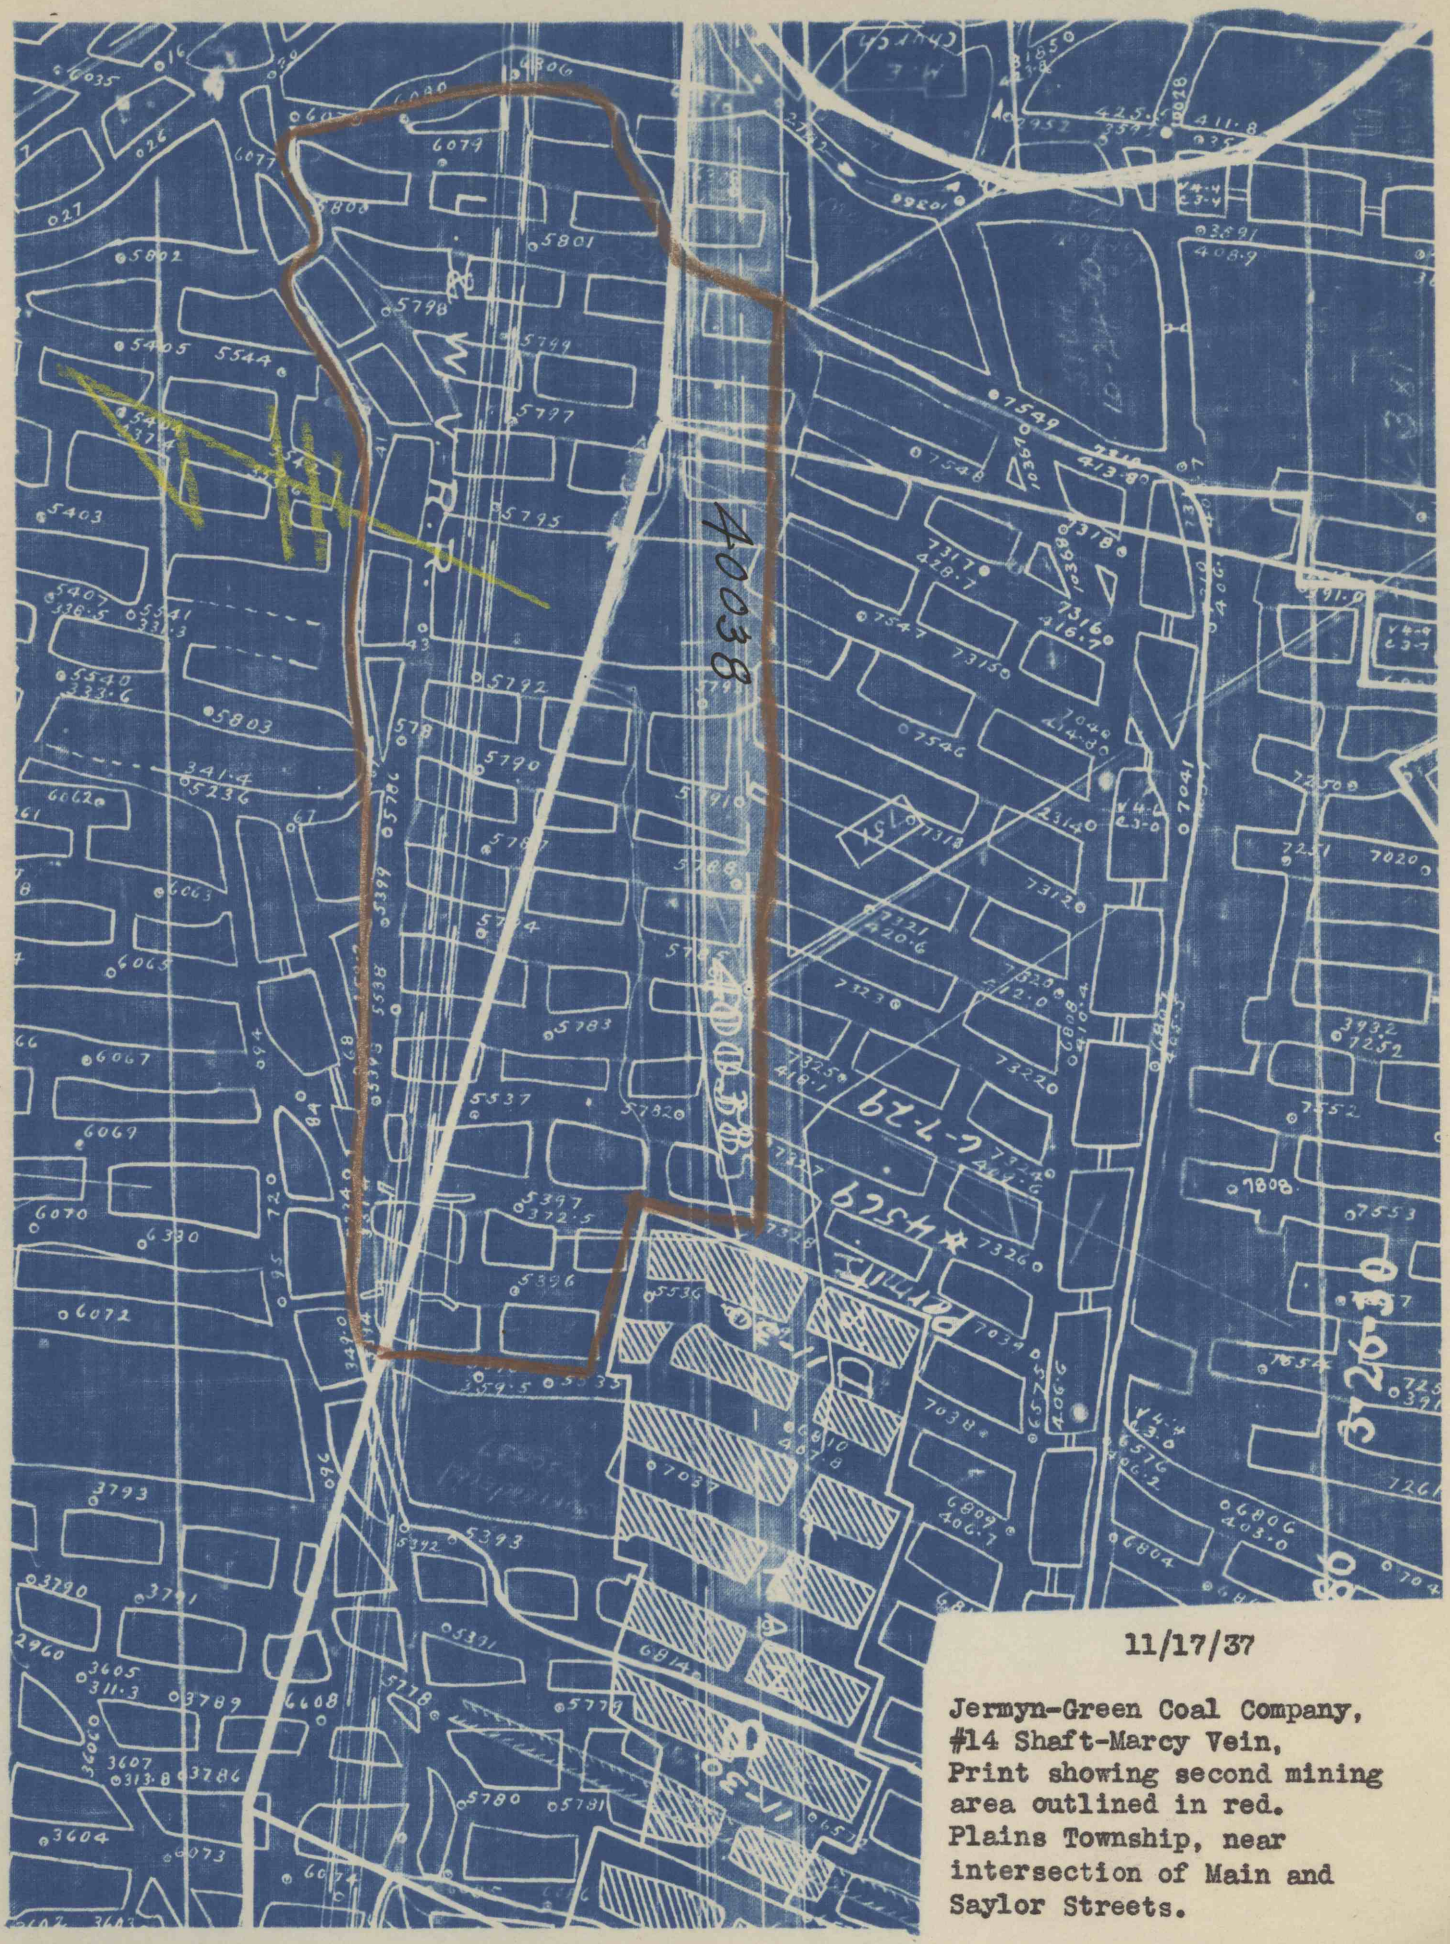

11/17/37

Jermyn-Green Coal Company,
#14 Shaft-Marcy Vein,
Print showing second mining
area outlined in red.
Plains Township, near
intersection of Main and
Saylor Streets.

Scale 1" = 100'