

L. & W. V. R.R.


STA
188+45

40038

STA
183+45

B.M. 6.
551.96.

MAIN

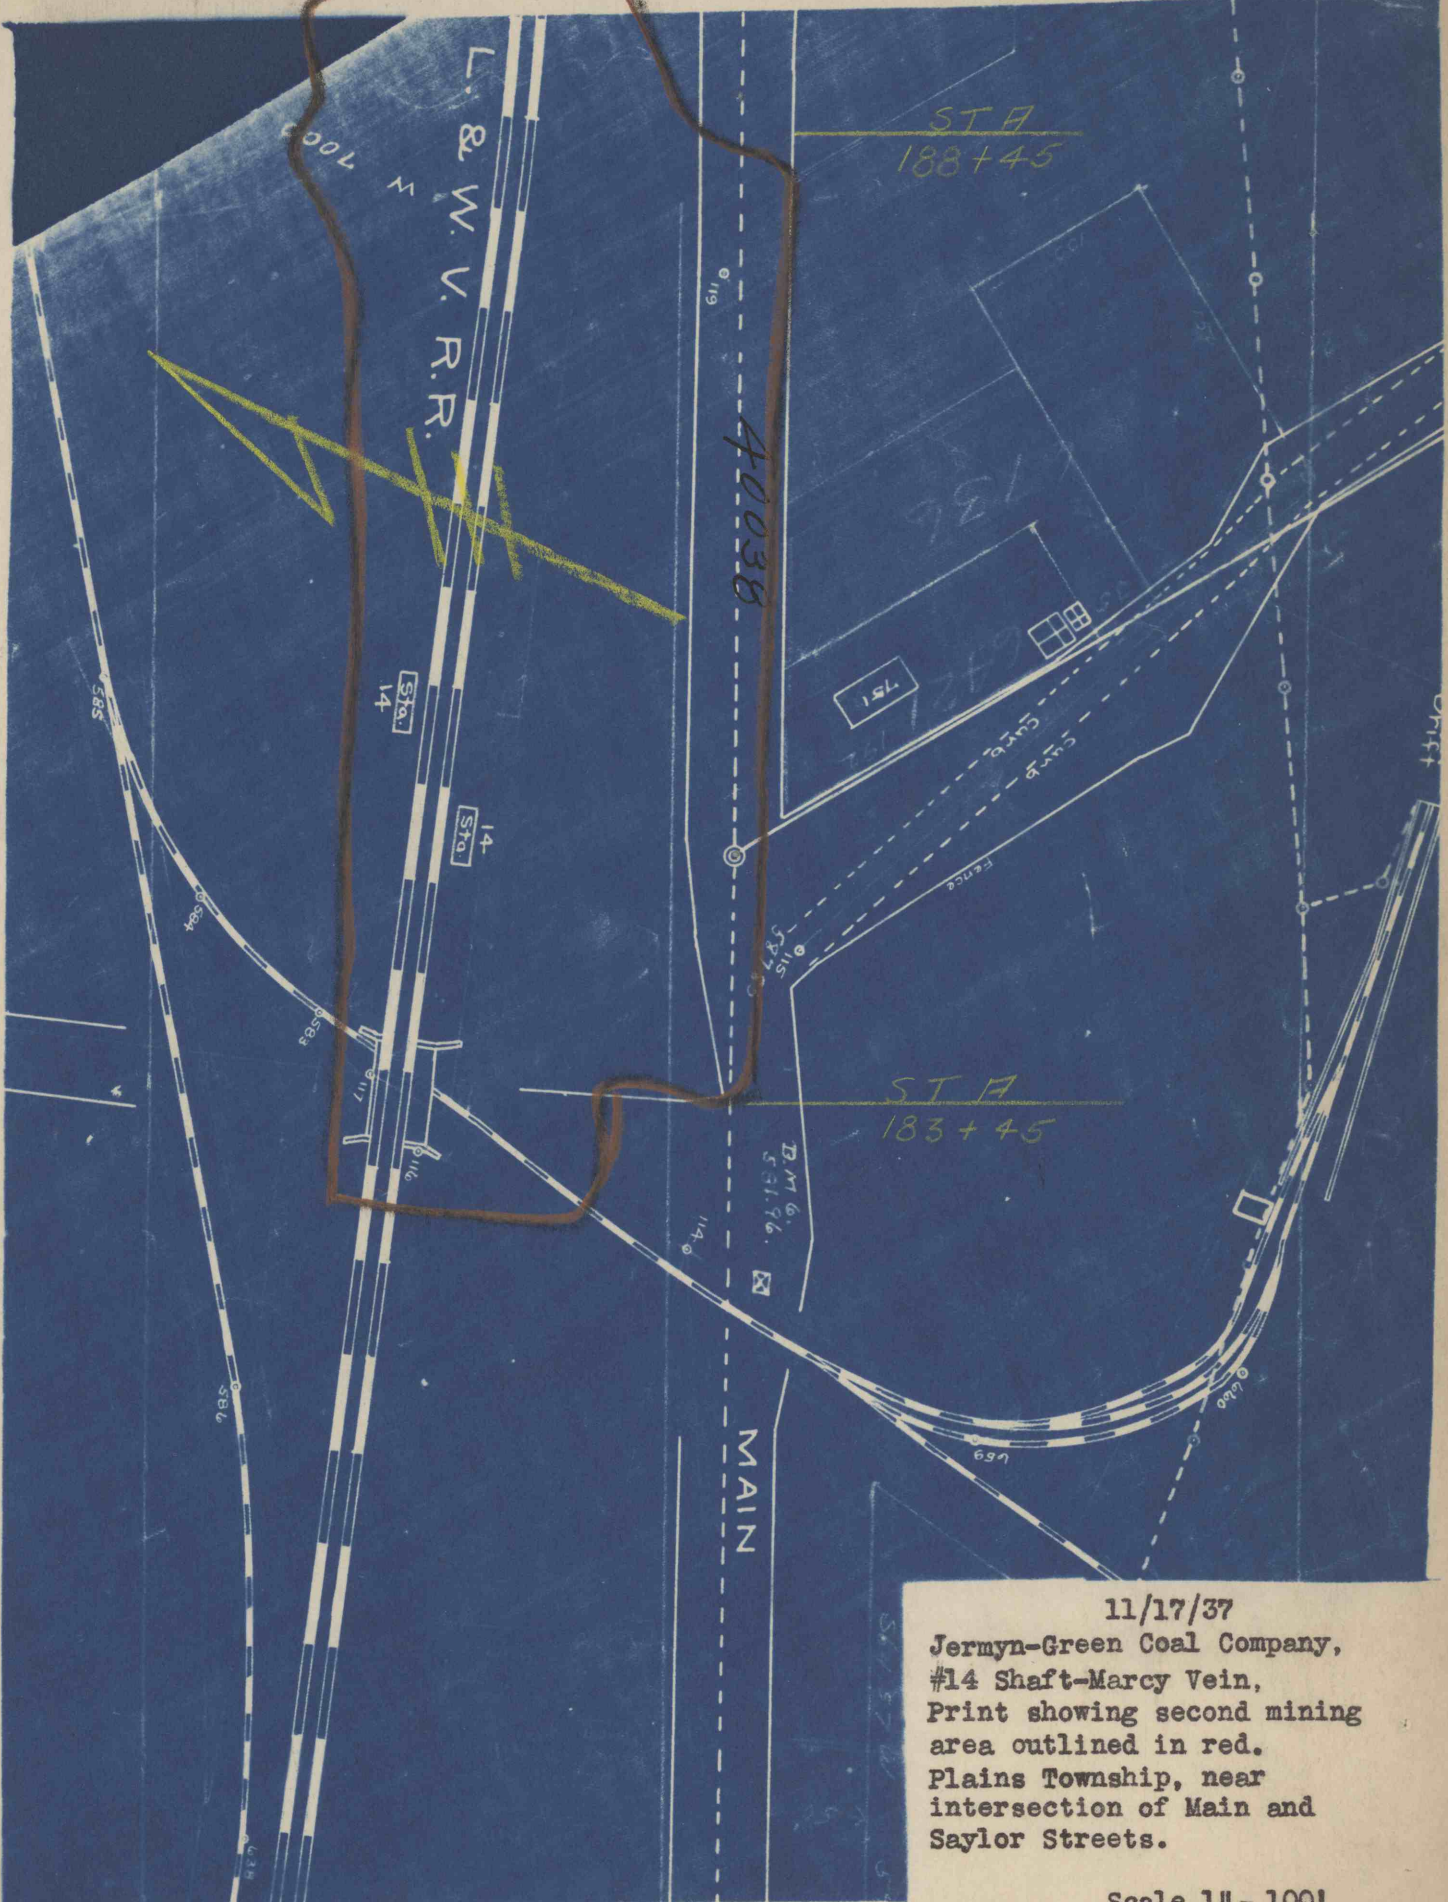

11/17/37
 Jermy-Green Coal Company,
 #14 Shaft-Marcy Vein,
 Print showing second mining
 area outlined in red.
 Plains Township, near
 intersection of Main and
 Saylor Streets.

Scale 1" = 100'