


# SECTION A-B

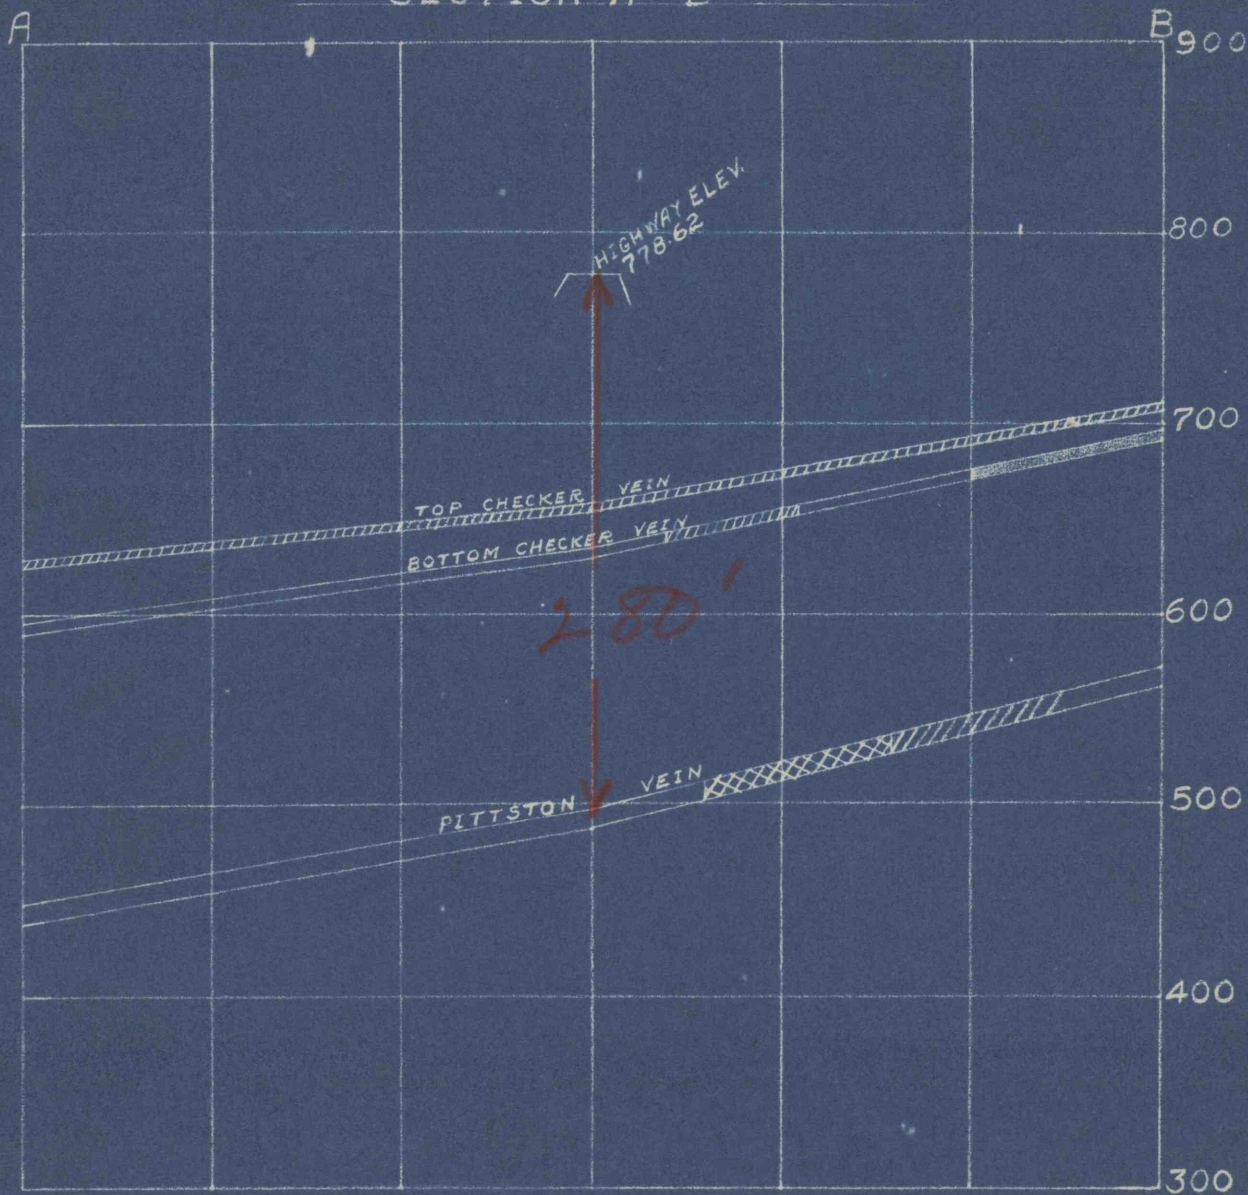

NO. 6 COLLIERY  
 No. 5 Shaft - - Pittston Vein  
 Scale 1" - 100'

Cross section of Pittston Vein  
 underlying Leg. Route #40038 in  
 Jenkins Twp., Luzerne Co., Pa.

- Virgin coal
- First mined
- Mining completed
- Rock packed