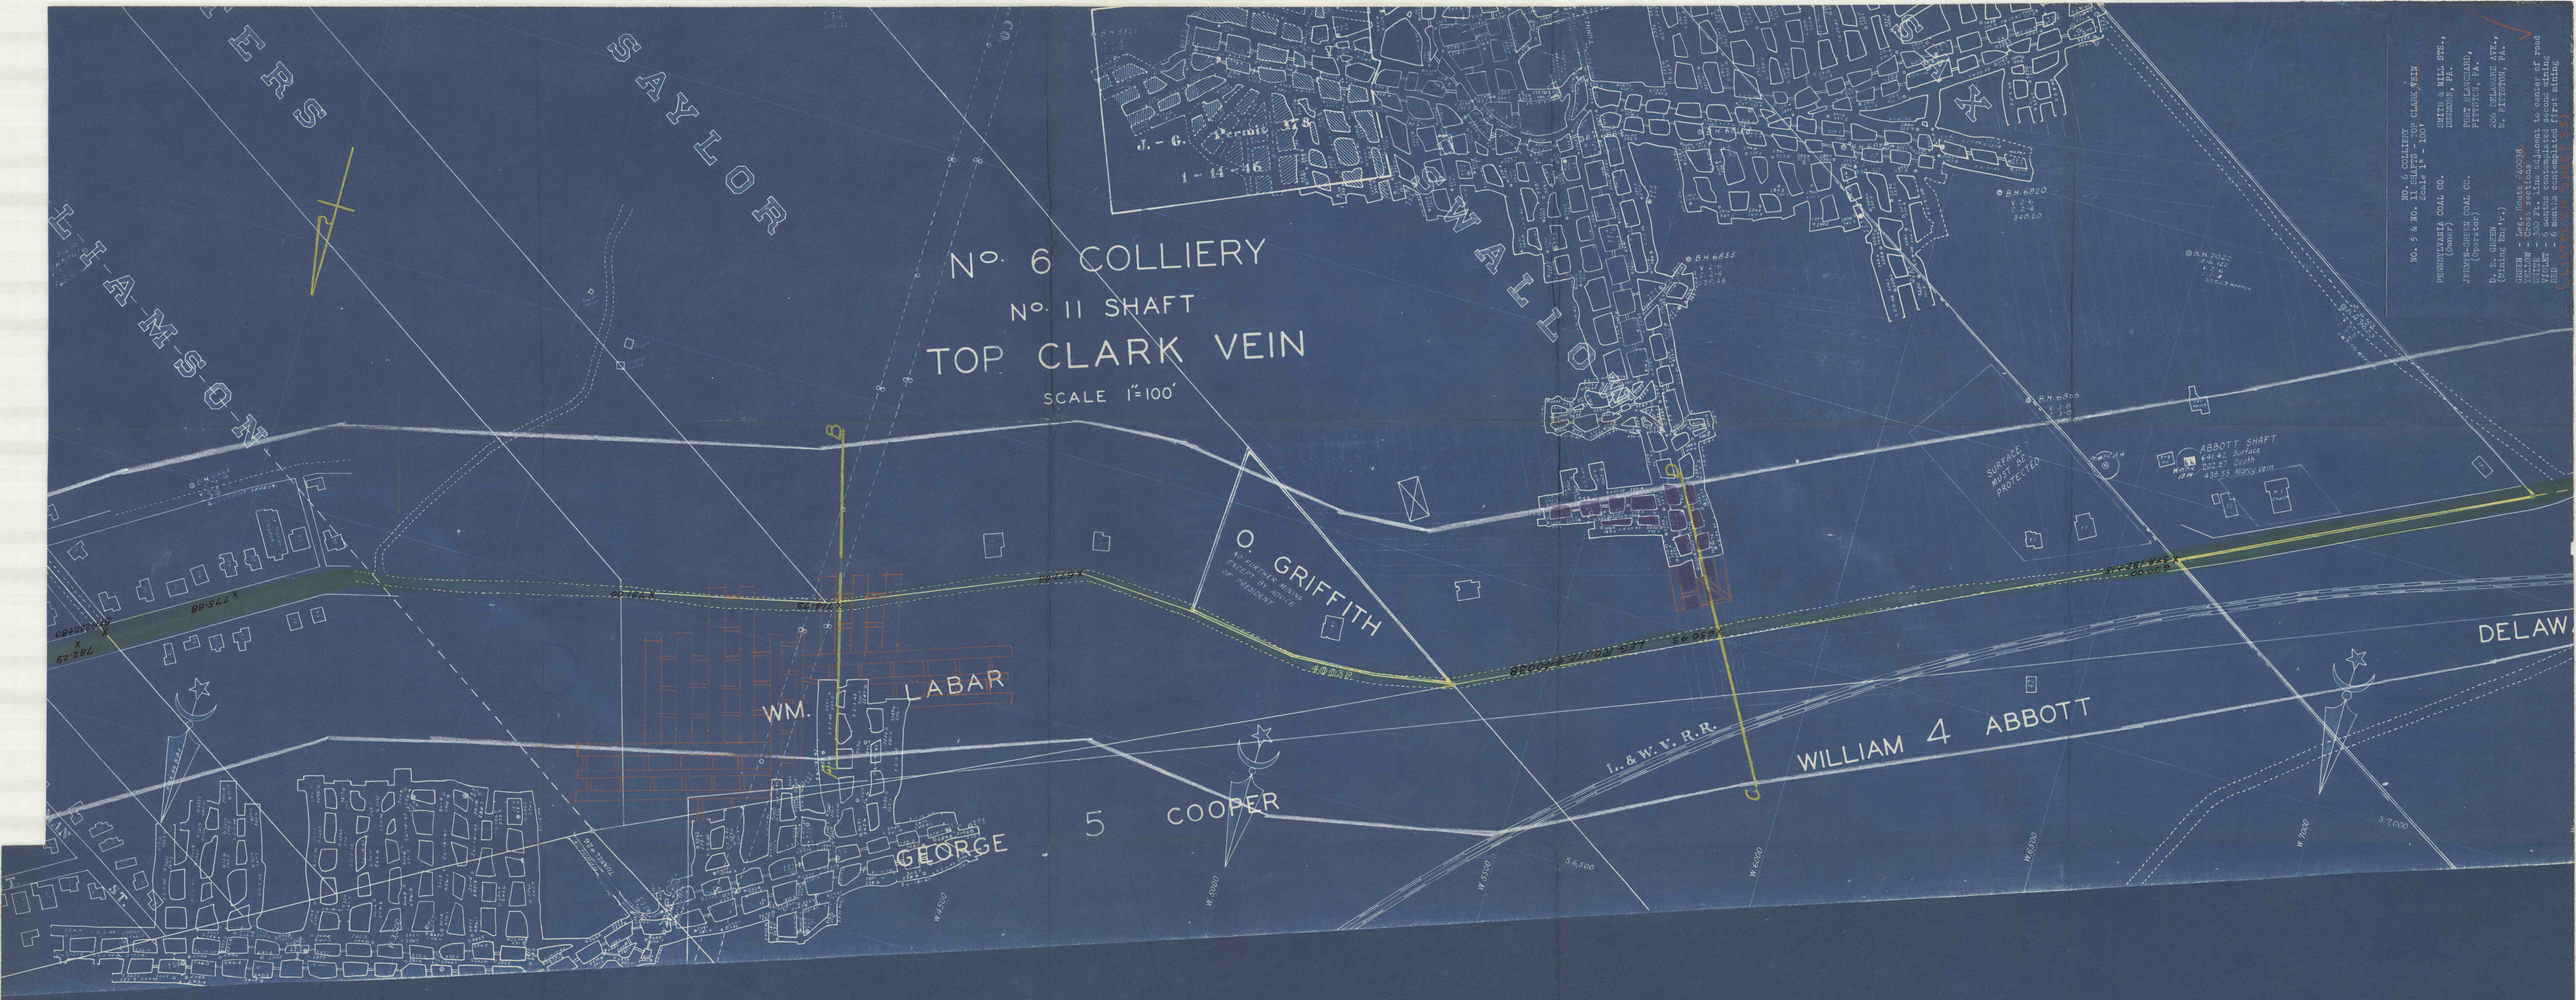
No. 6 COLLIERY
No. 11 SHAFT
TOP CLARK VEIN
SCALE 1"=100'
J. - 6. Permit 178
1 - 14 - 46
SAYLOR
WILLIAMSON
O. GRIFFITH
WM. LABAR
GEORGE 5 COOPER
WILLIAM 4 ABBOTT
L. & W. V. R.R.
ABBOTT SHAFT
DELAW
SURFACE MUST BE PROTECTED
NO. 6 COLLIERY
NO. 5 & NO. 11 SHAFTS - TOP CLARK VEIN
(Scale 1" = 100')
PENNSYLVANIA COAL CO.
(Owner)
POST OFFICE ADDRESS
JERMYN-ARCHBALD COAL CO.
(Lessee)
JERMYN, PA.
W. PITTSTON, PA.
