


# Section A-B

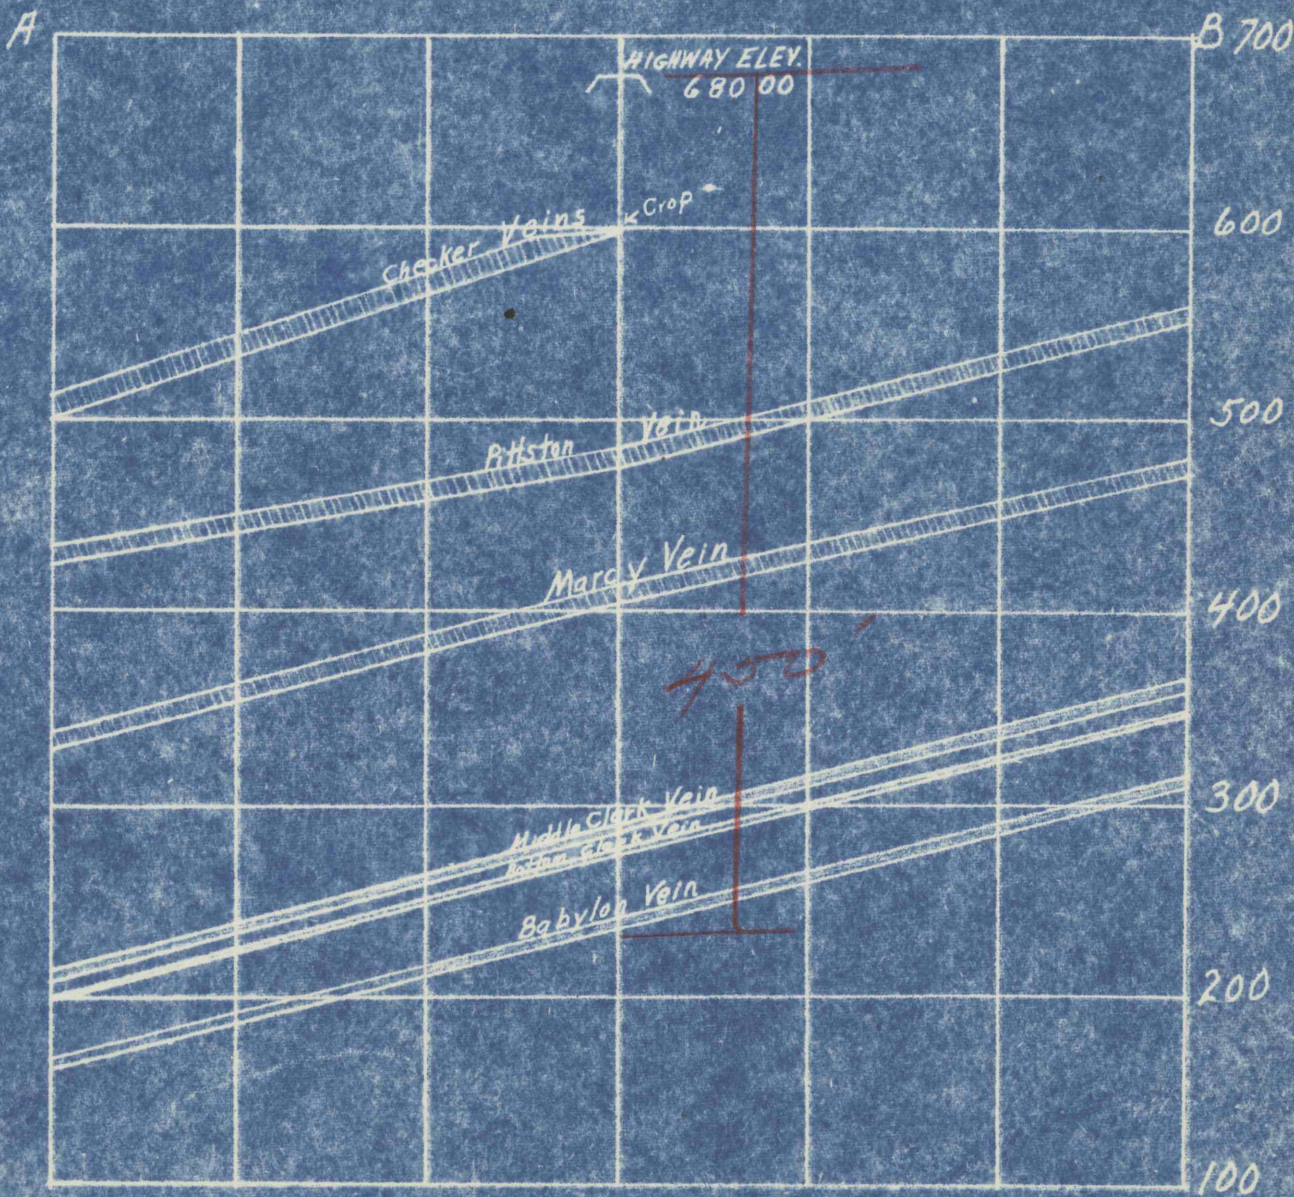

NO. 14 COLLIERY  
 Clark Shaft - - Babylon Vein  
 Scale 1" = 100'

Cross section of Babylon Vein  
 underlying Leg. Route #40038 in  
 Jenkins Twp., Luzerne Co., Penna.

-  Virgin coal
-  First mining
-  Complete mining