


Section A - B

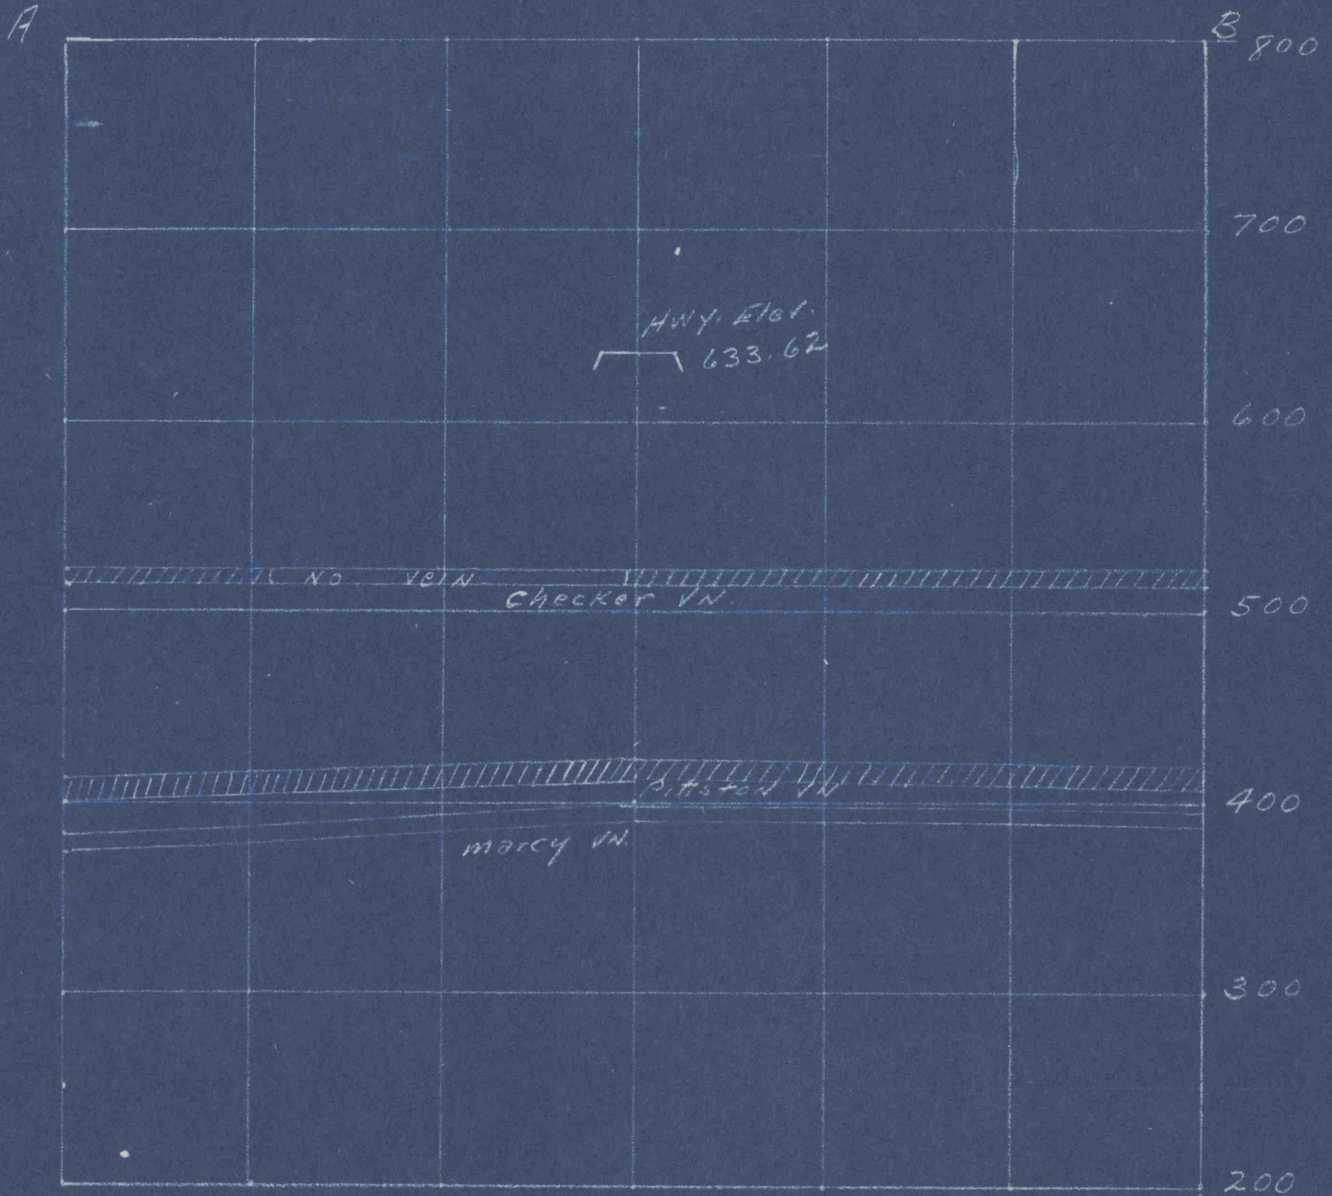




1<sup>st</sup> mining under + within 300'  
of Hwy adj to Sta. 305+00 + 313+00  
Pittston City + Jenkins Twp

2

EWEN COLLIERY  
No. 4 & No. 7 Shafts - Marcy Vein  
Scale 1" = 100'

Cross section of Marcy Vein under-  
lying Leg. Route No. 40038 in  
Pittston City and Jenkins Township,  
Luzerne Co., Pa.

-  Virgin coal
-  First mining
-  Mining completed