


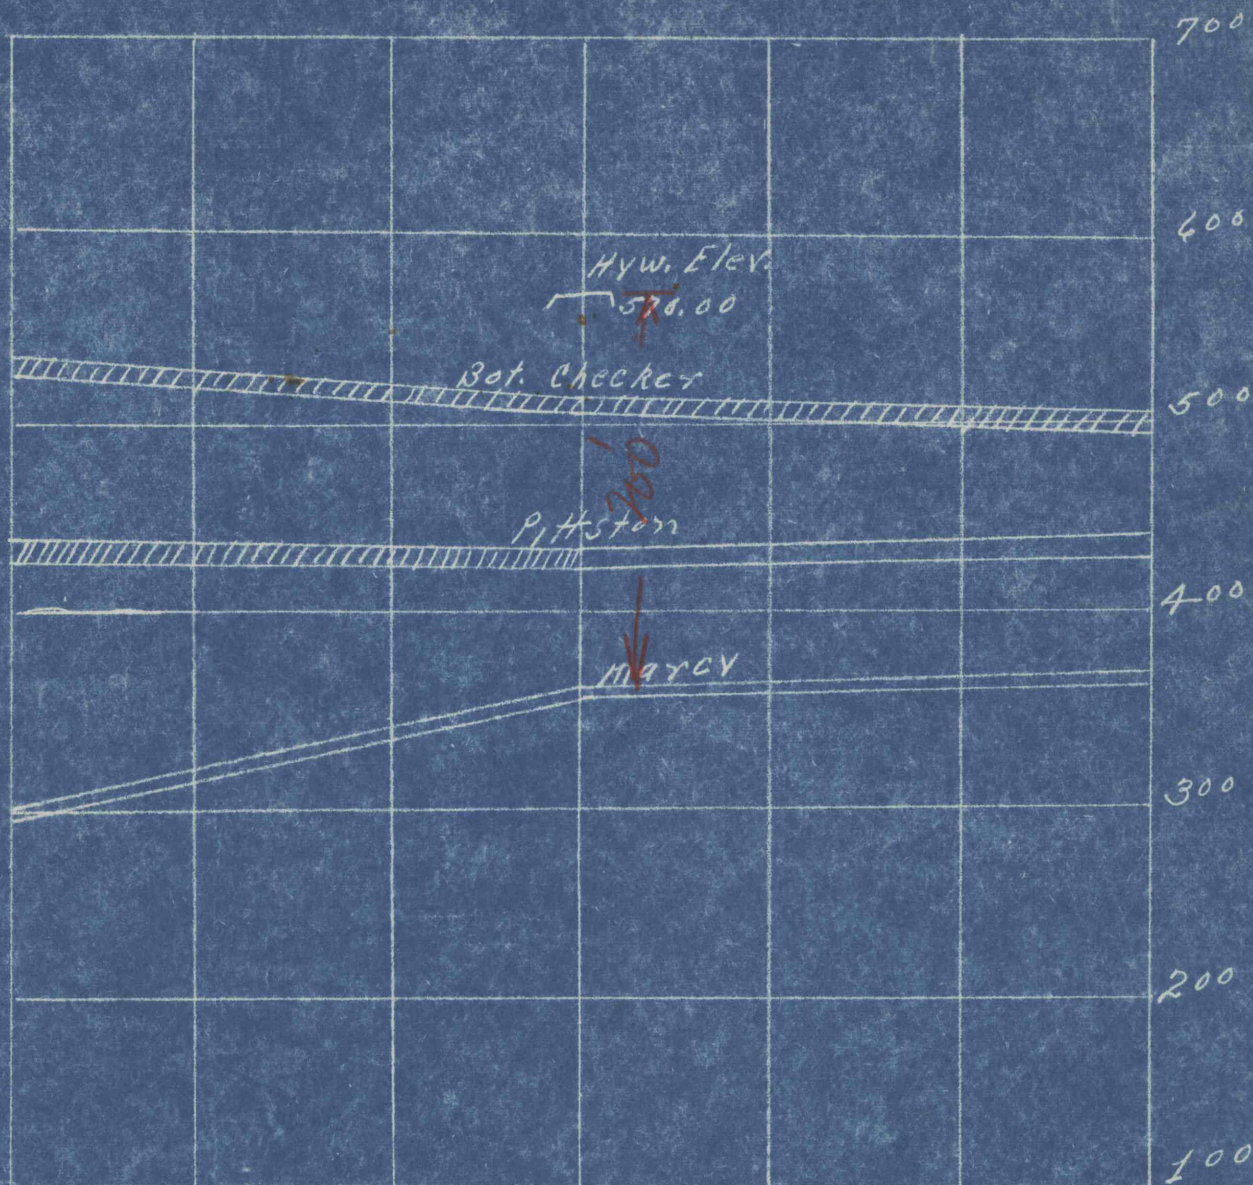


SECTION A-B



NO. 14 COLLIERY
No. 14 Drifts- Marcy Vein
Scale 1"-100'

Cross section of Marcy Vein
underlying Leg. Route #40038
in Plains Twp., Luz. Co. Pa.

-  Virgin coal
-  First mining
-  Complete mining.