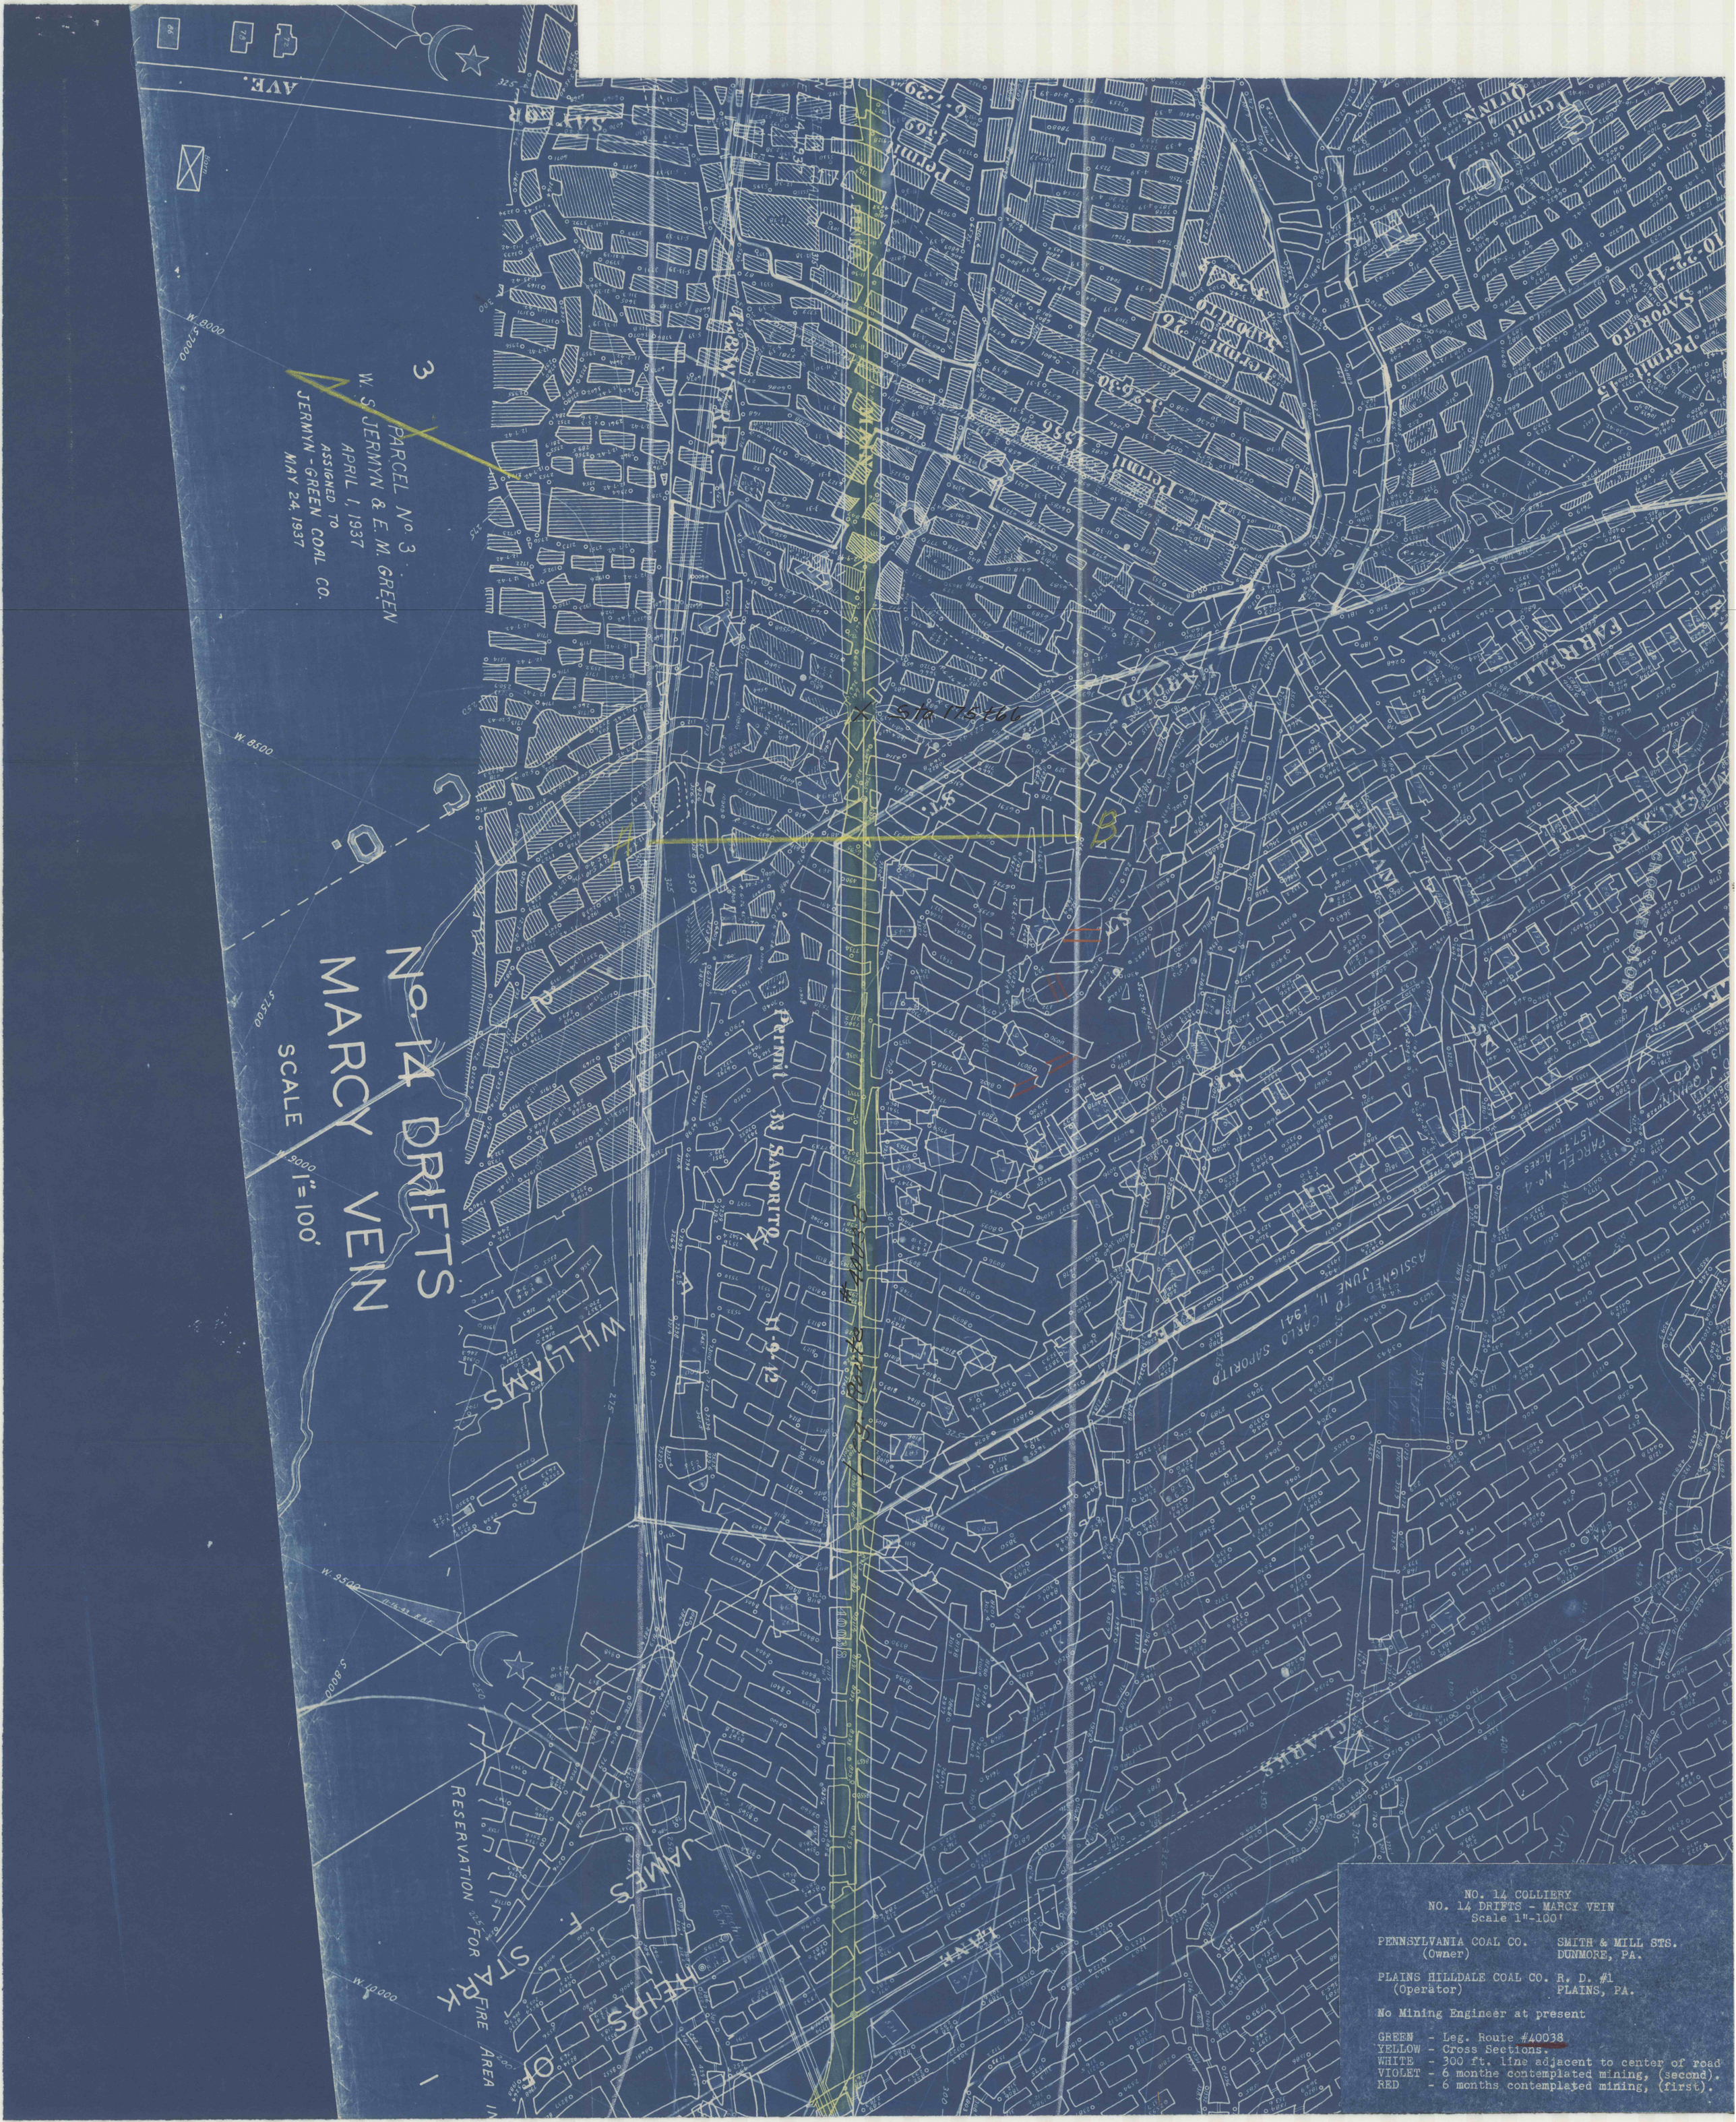
NO. 14 DRIFTS
MARCY VEIN
SCALE 1"=100'
PARCEL No. 3
W. S. JERMYN & E. M. GREEN
APRIL 1, 1937
ASSIGNED TO
JERMYN-GREEN COAL CO.
MAY 24, 1937
PARCEL No. 4
157.27 ACRES
ASSIGNED TO CARLO SAPORITO
JUNE 11, 1941
SAPORITO
WILLIAMS
JAMES
STARK
RESERVATION FOR FIRE AREA
NO. 14 COLLIERY
NO. 14 DRIFTS - MARCY VEIN
Scale 1"-100'
PENNSYLVANIA COAL CO. (Owner)
SMITH & MILL STS.
DUNMORE, PA.
PLAINS HILLDALE COAL CO. (Operator)
R. D. #1
PLAINS, PA.
No Mining Engineer at present
GREEN - Leg. Route #40038
YELLOW - Cross Sections.
WHITE - 300 ft. line adjacent to center of road
VIOLET - 6 monthe contemplated mining, (second).
RED - 6 months contemplated mining, (first).