


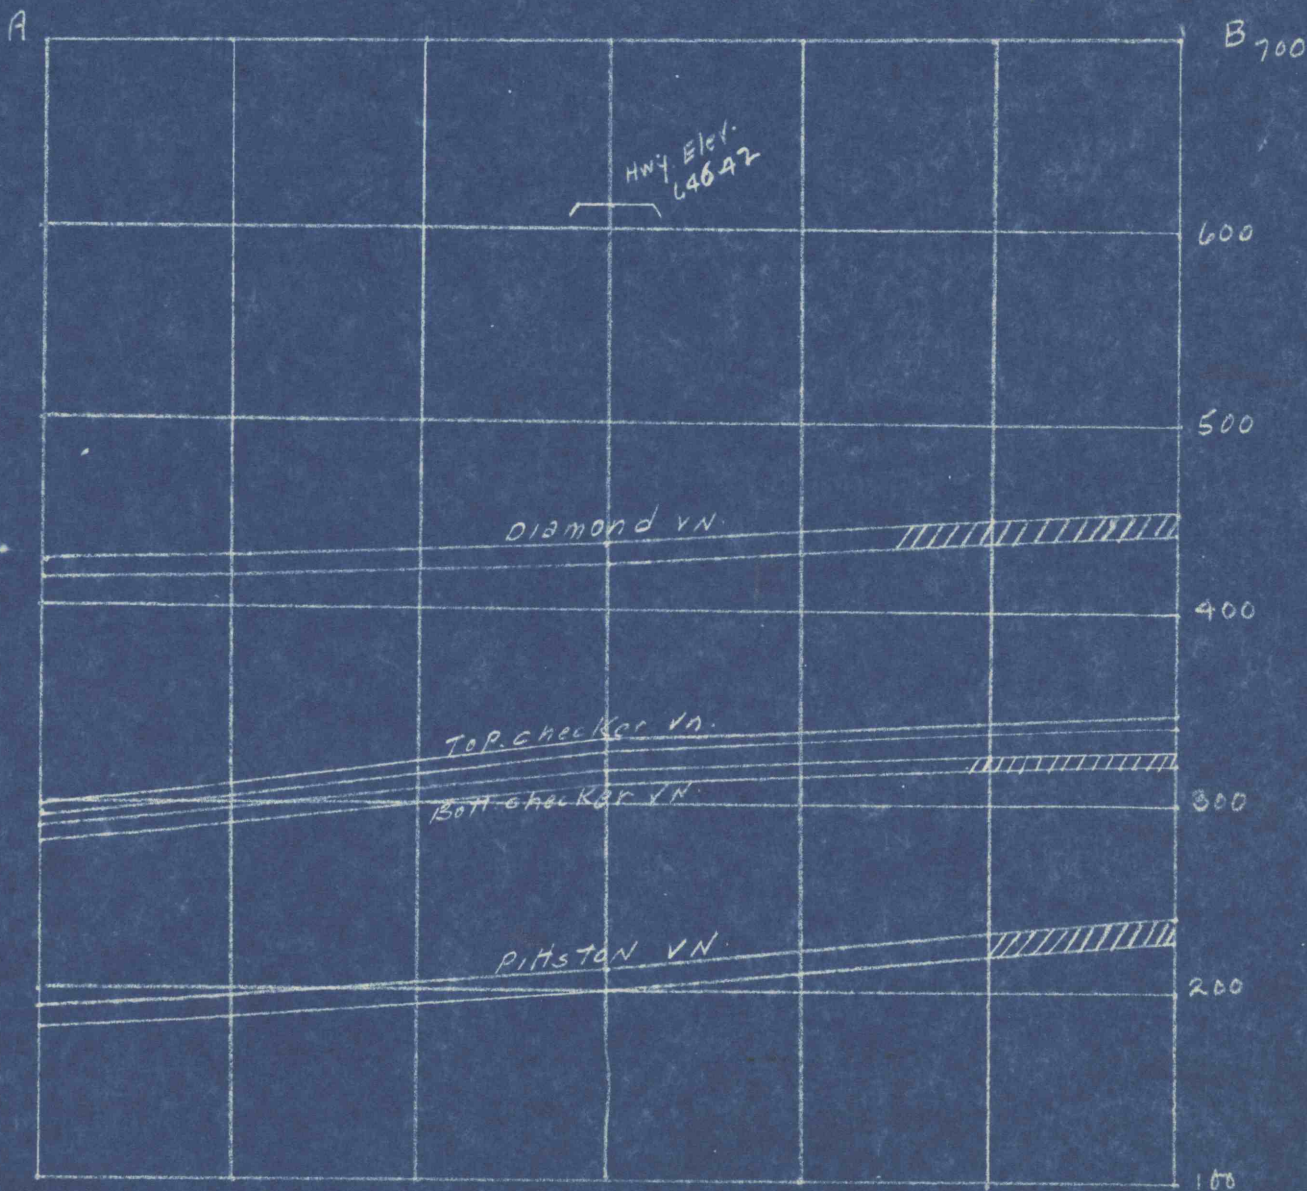


SECTION A - B -



8

NO. 14 COLLIERY  
 No. 14 Shaft ----- Pittston Vein  
 Scale 1" - 100'

Cross section of Pittston Vein  
 underlying Leg. Route #40038 in  
 Plains Twp., Luzerne Co., Penna.

-  Virgin coal
-  First mined
-  Complete mining