


SECTION A - B:

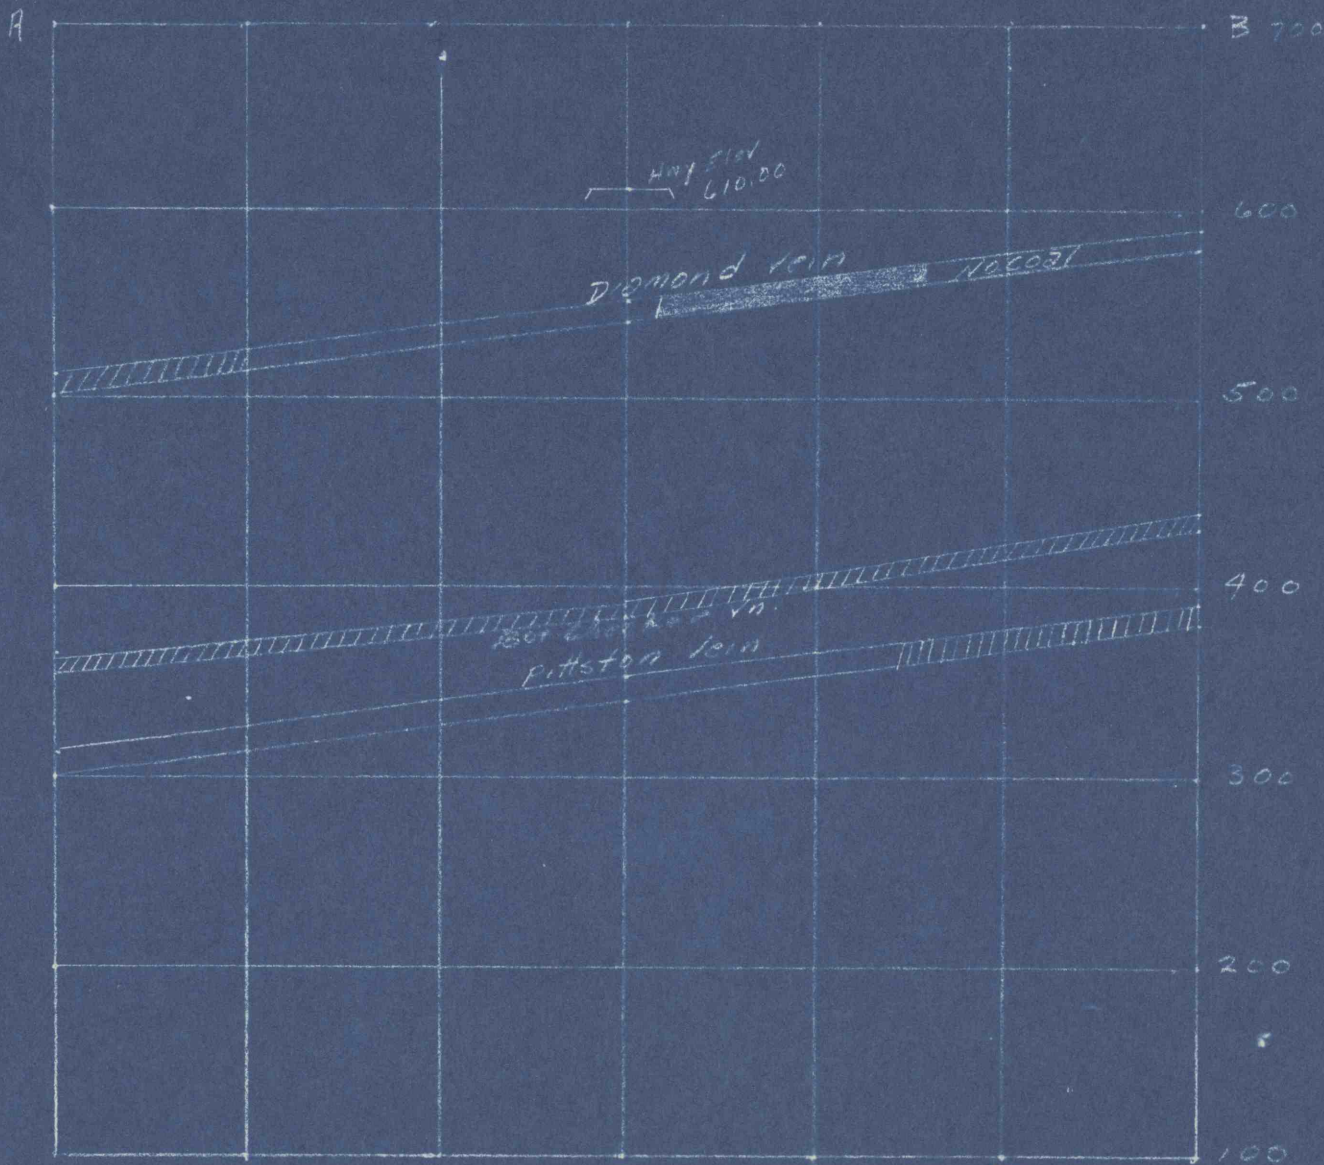

8

NO. 14 COLLIERY
 No. 14 Shaft - - - - - Pittston Vein
 Scale 1" = 100'

Cross section of Pittston Vein underlying Leg. Route #40038 in Plains Township, Luzerne County, Penna.

-  Virgin coal
-  First mining
-  Complete mining