


CROSS SECTION A-B.

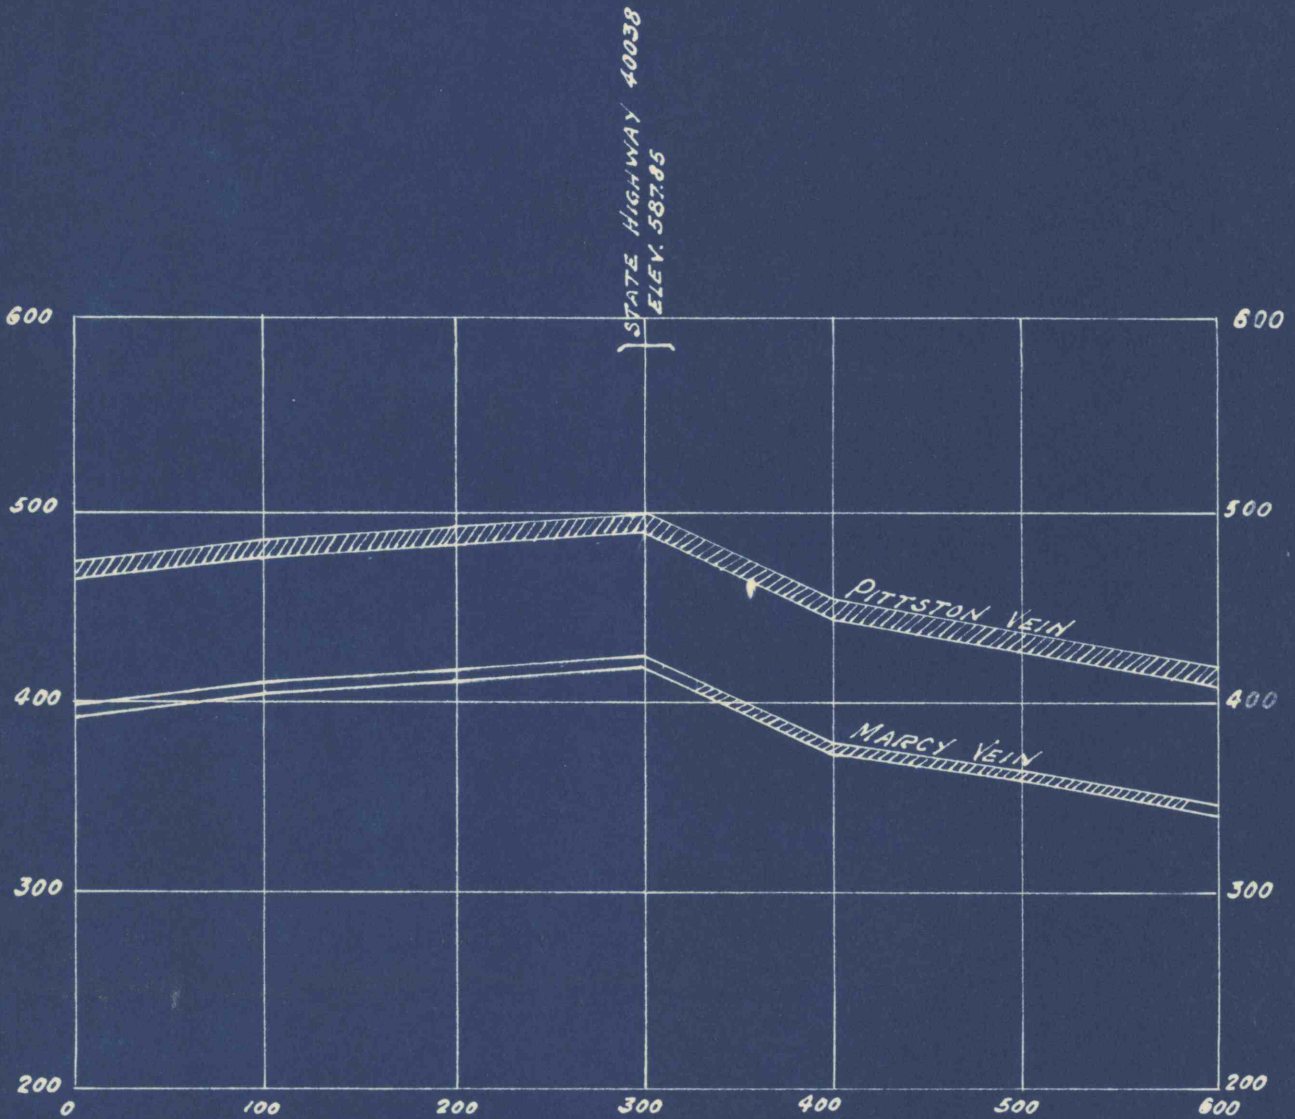

NO.14 COLLIERY
NO.14 DRIFTS
PAUL SINDACO & SONS

Scale 1" - 100'

2-20-39

Cross section of Legislative Route
No.40038 showing Pittston and Marcy
Veins, Plains Twp.



Mining Completed