
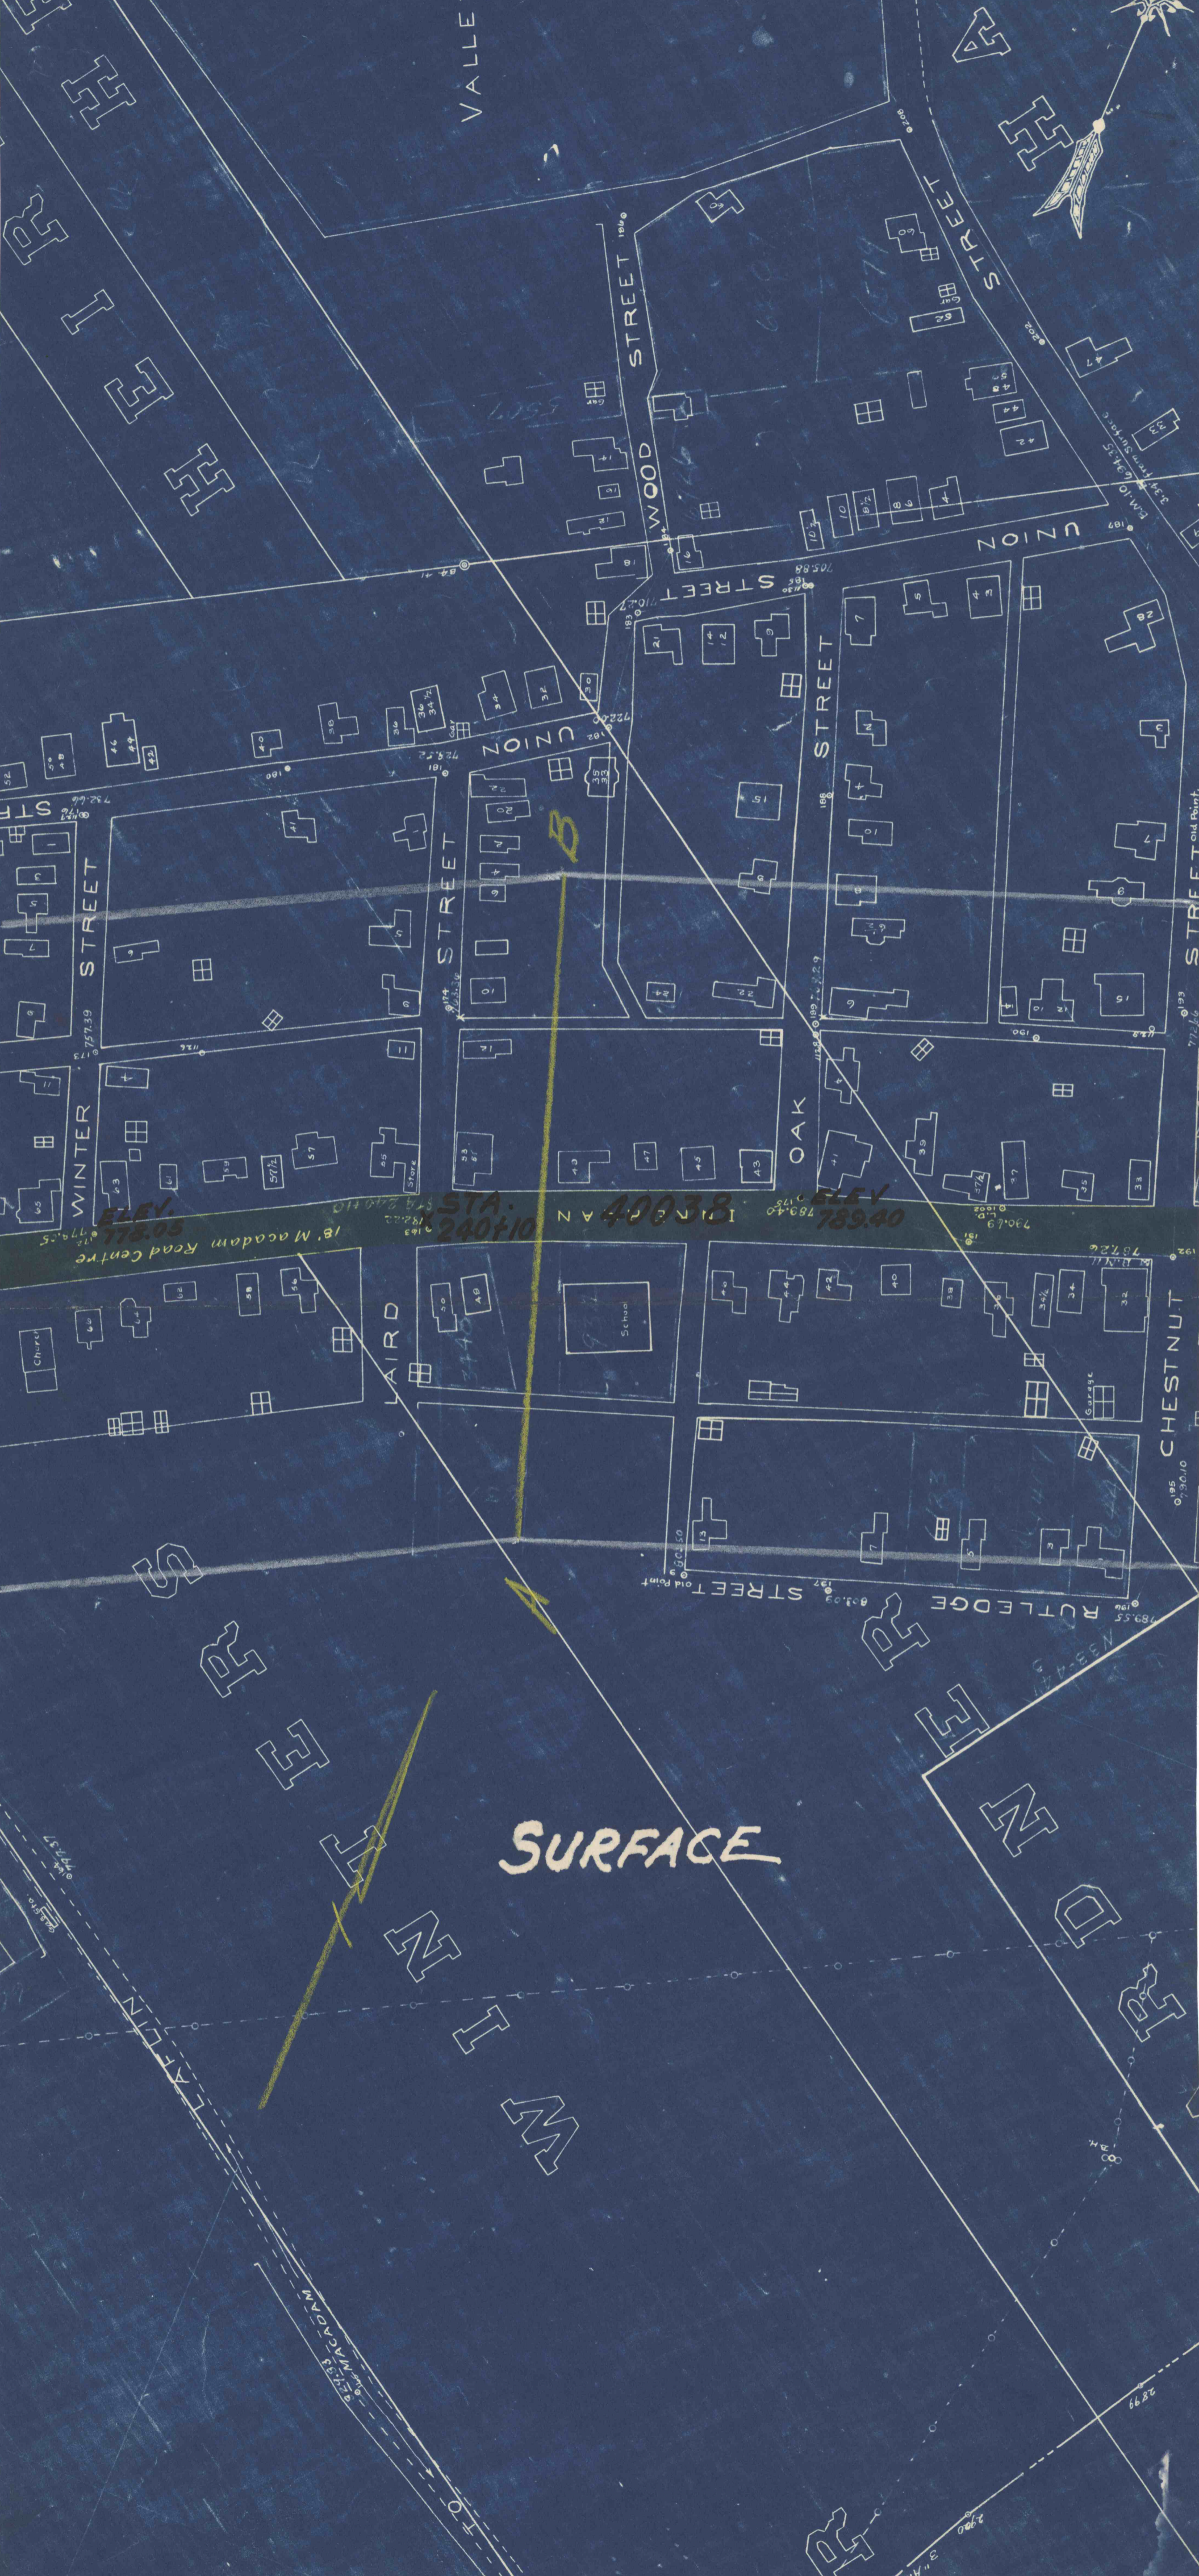


VALLEY

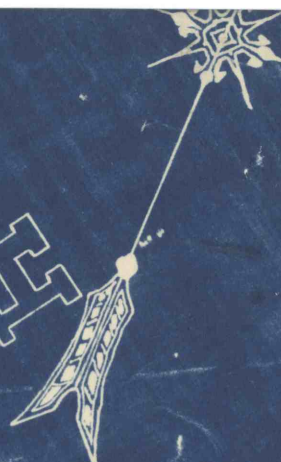

SURFACE

18. Macadam Road Centre

STA. 240+10

ELEV. 789.40

I 40038

WINTER STREET
LAIRD STREET
RUTLEDGE STREET
CHESTNUT STREET
OAK STREET
UNION STREET
WOOD STREET

3" = 100'