


CROSS SECTION A-B.

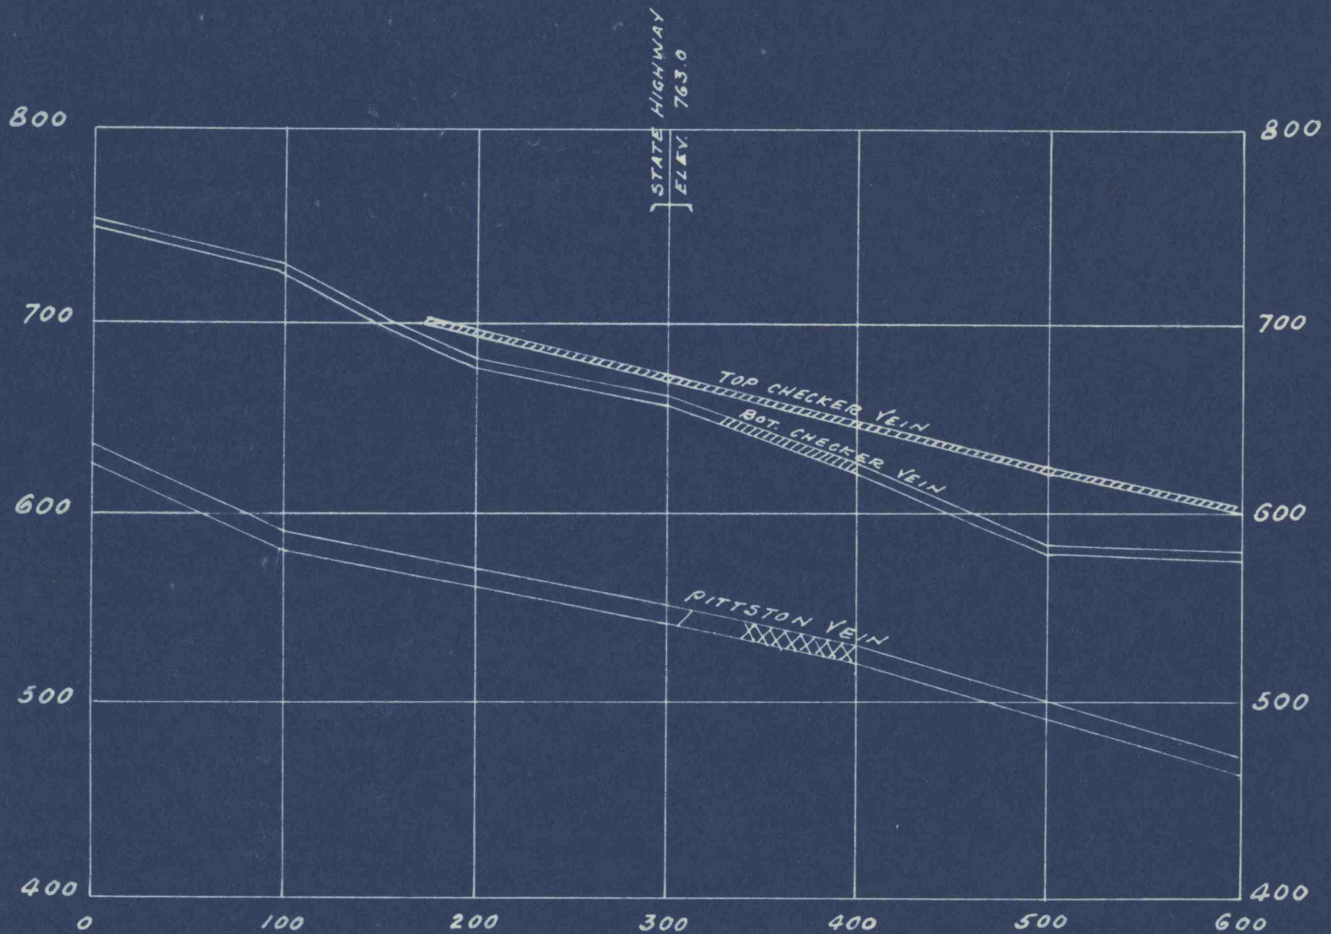

NO. 6 COLLIERY
VOLPE COAL COMPANY

Cross section of Legislative
Route No. 40038 showing Top Checker,
Bottom Checker & Pittston Veins,
Jenkins Twp.

Scale 1" - 100' 2-15-39.

Mining Completed.

Rock filled.