


CROSS SECTION A-B.

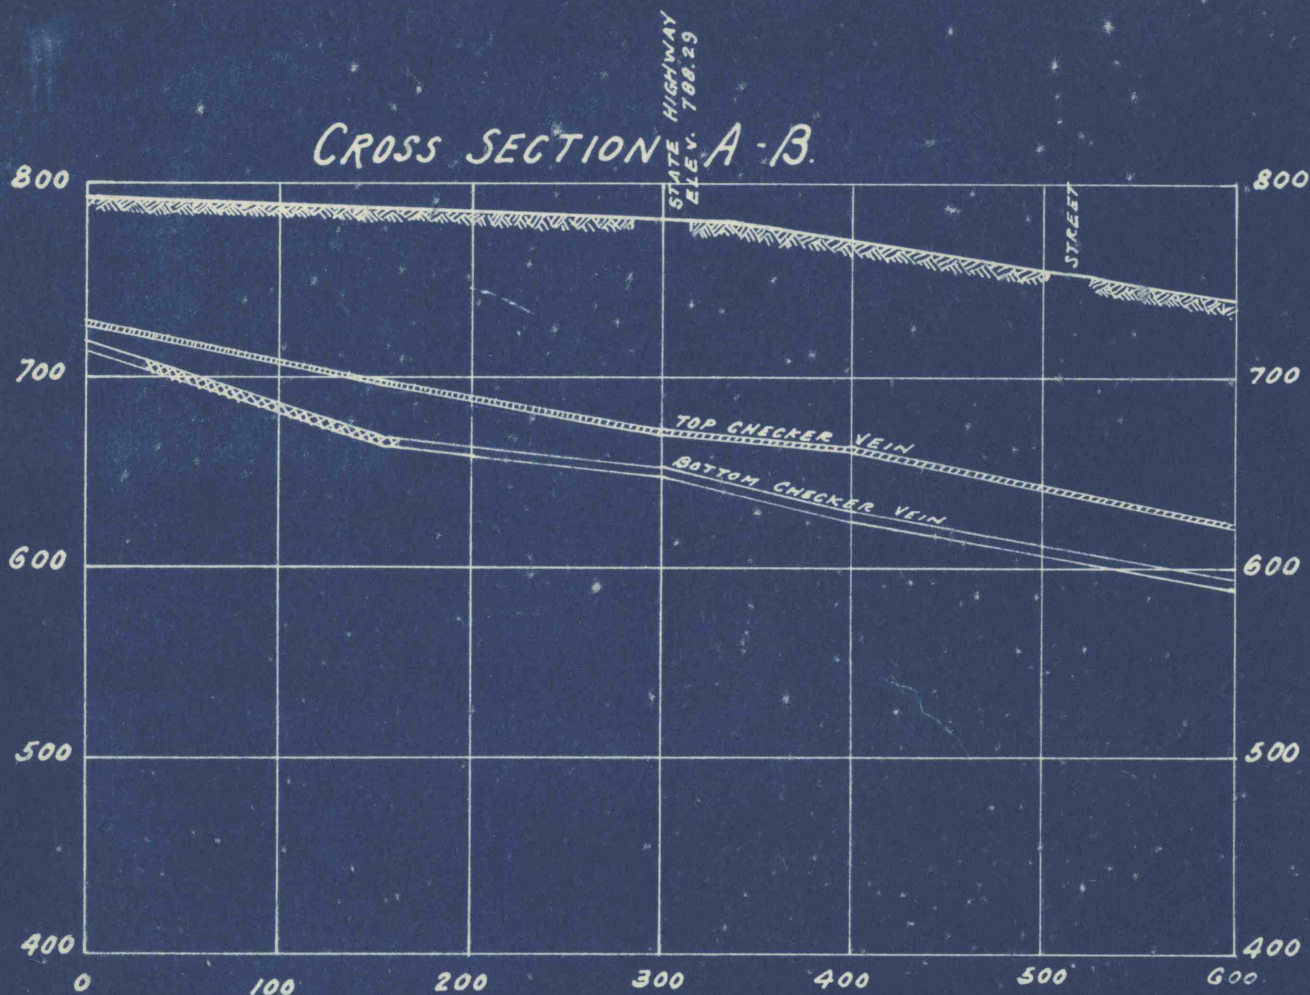

NO. 6 COLLIERY
VOLPE COAL COMPANY

Cross section of Legislative Route
No. 40038 showing Top Checker and
Bottom Checker Veins, Jenkins Twp.

Scale 1" - 100'

2-15-39

Mining Completed

Rock Filled