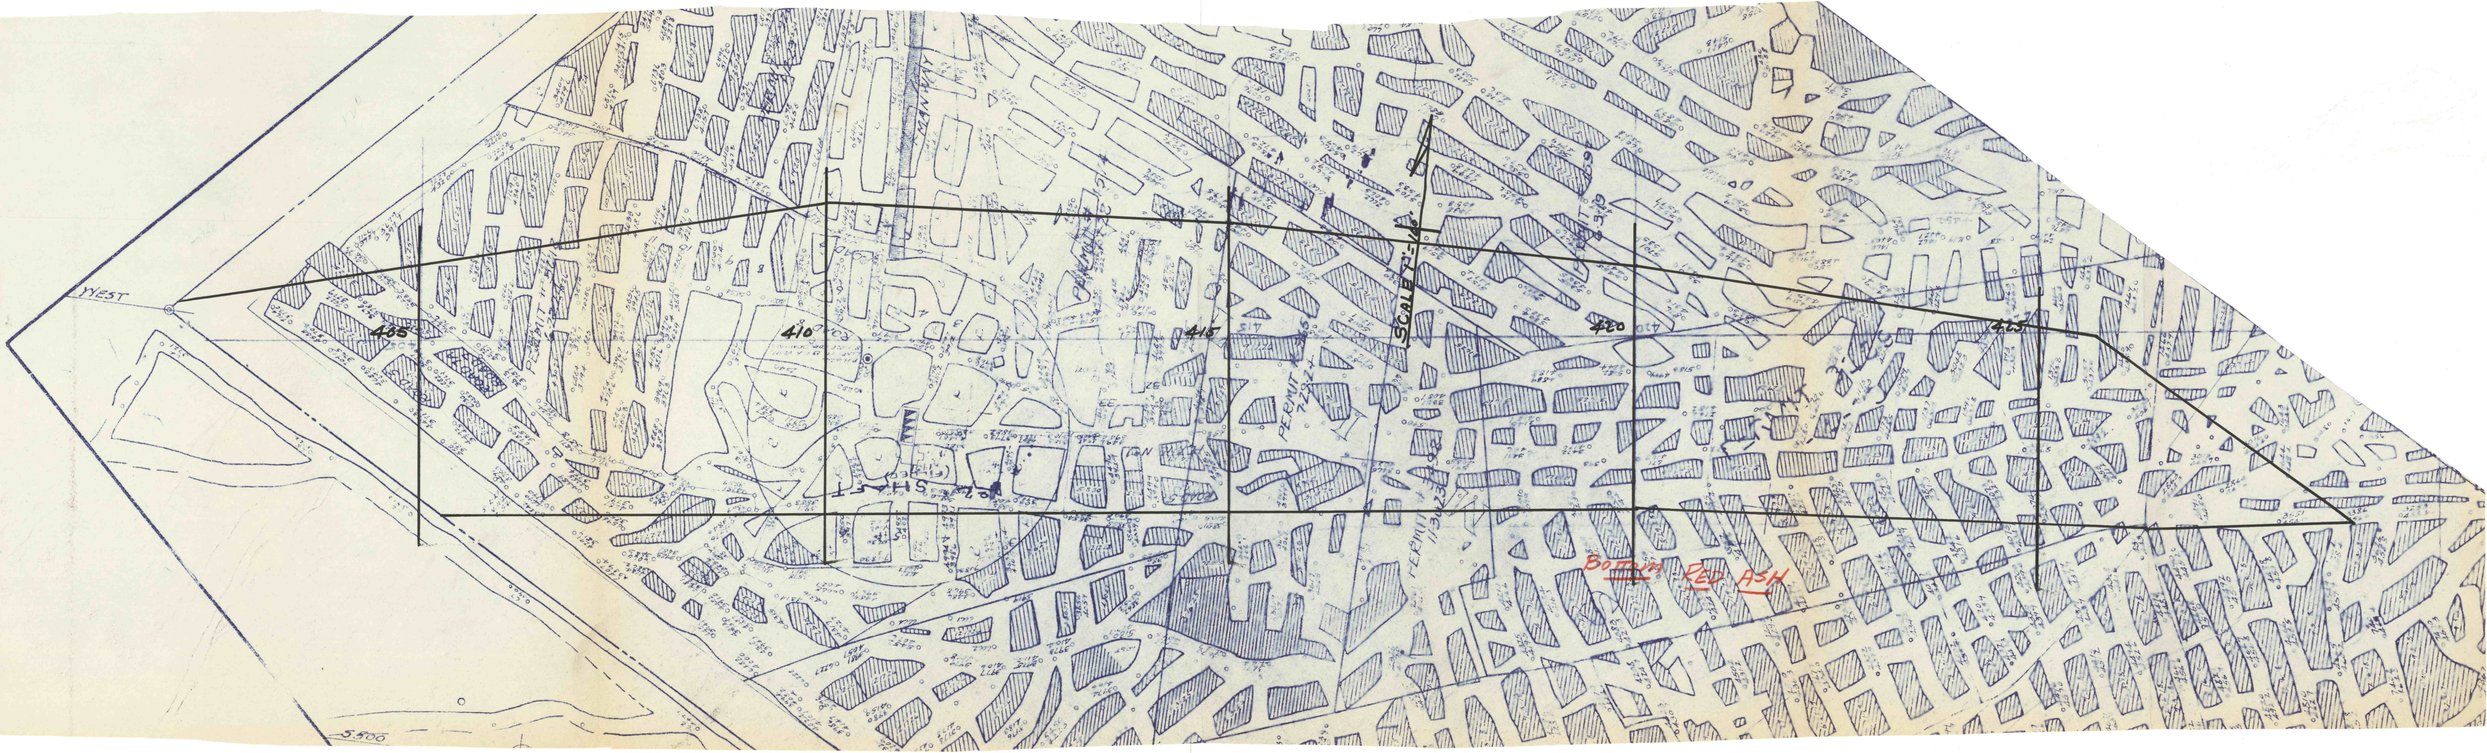
WEST
405
410
415
420
425
SCALE 1"=40'
Bottom Red Ash