


AIR SHAFT

JOHN D SHAFER

OF GEORGE NAFUS

ISAAC NAFUS

SURFACE

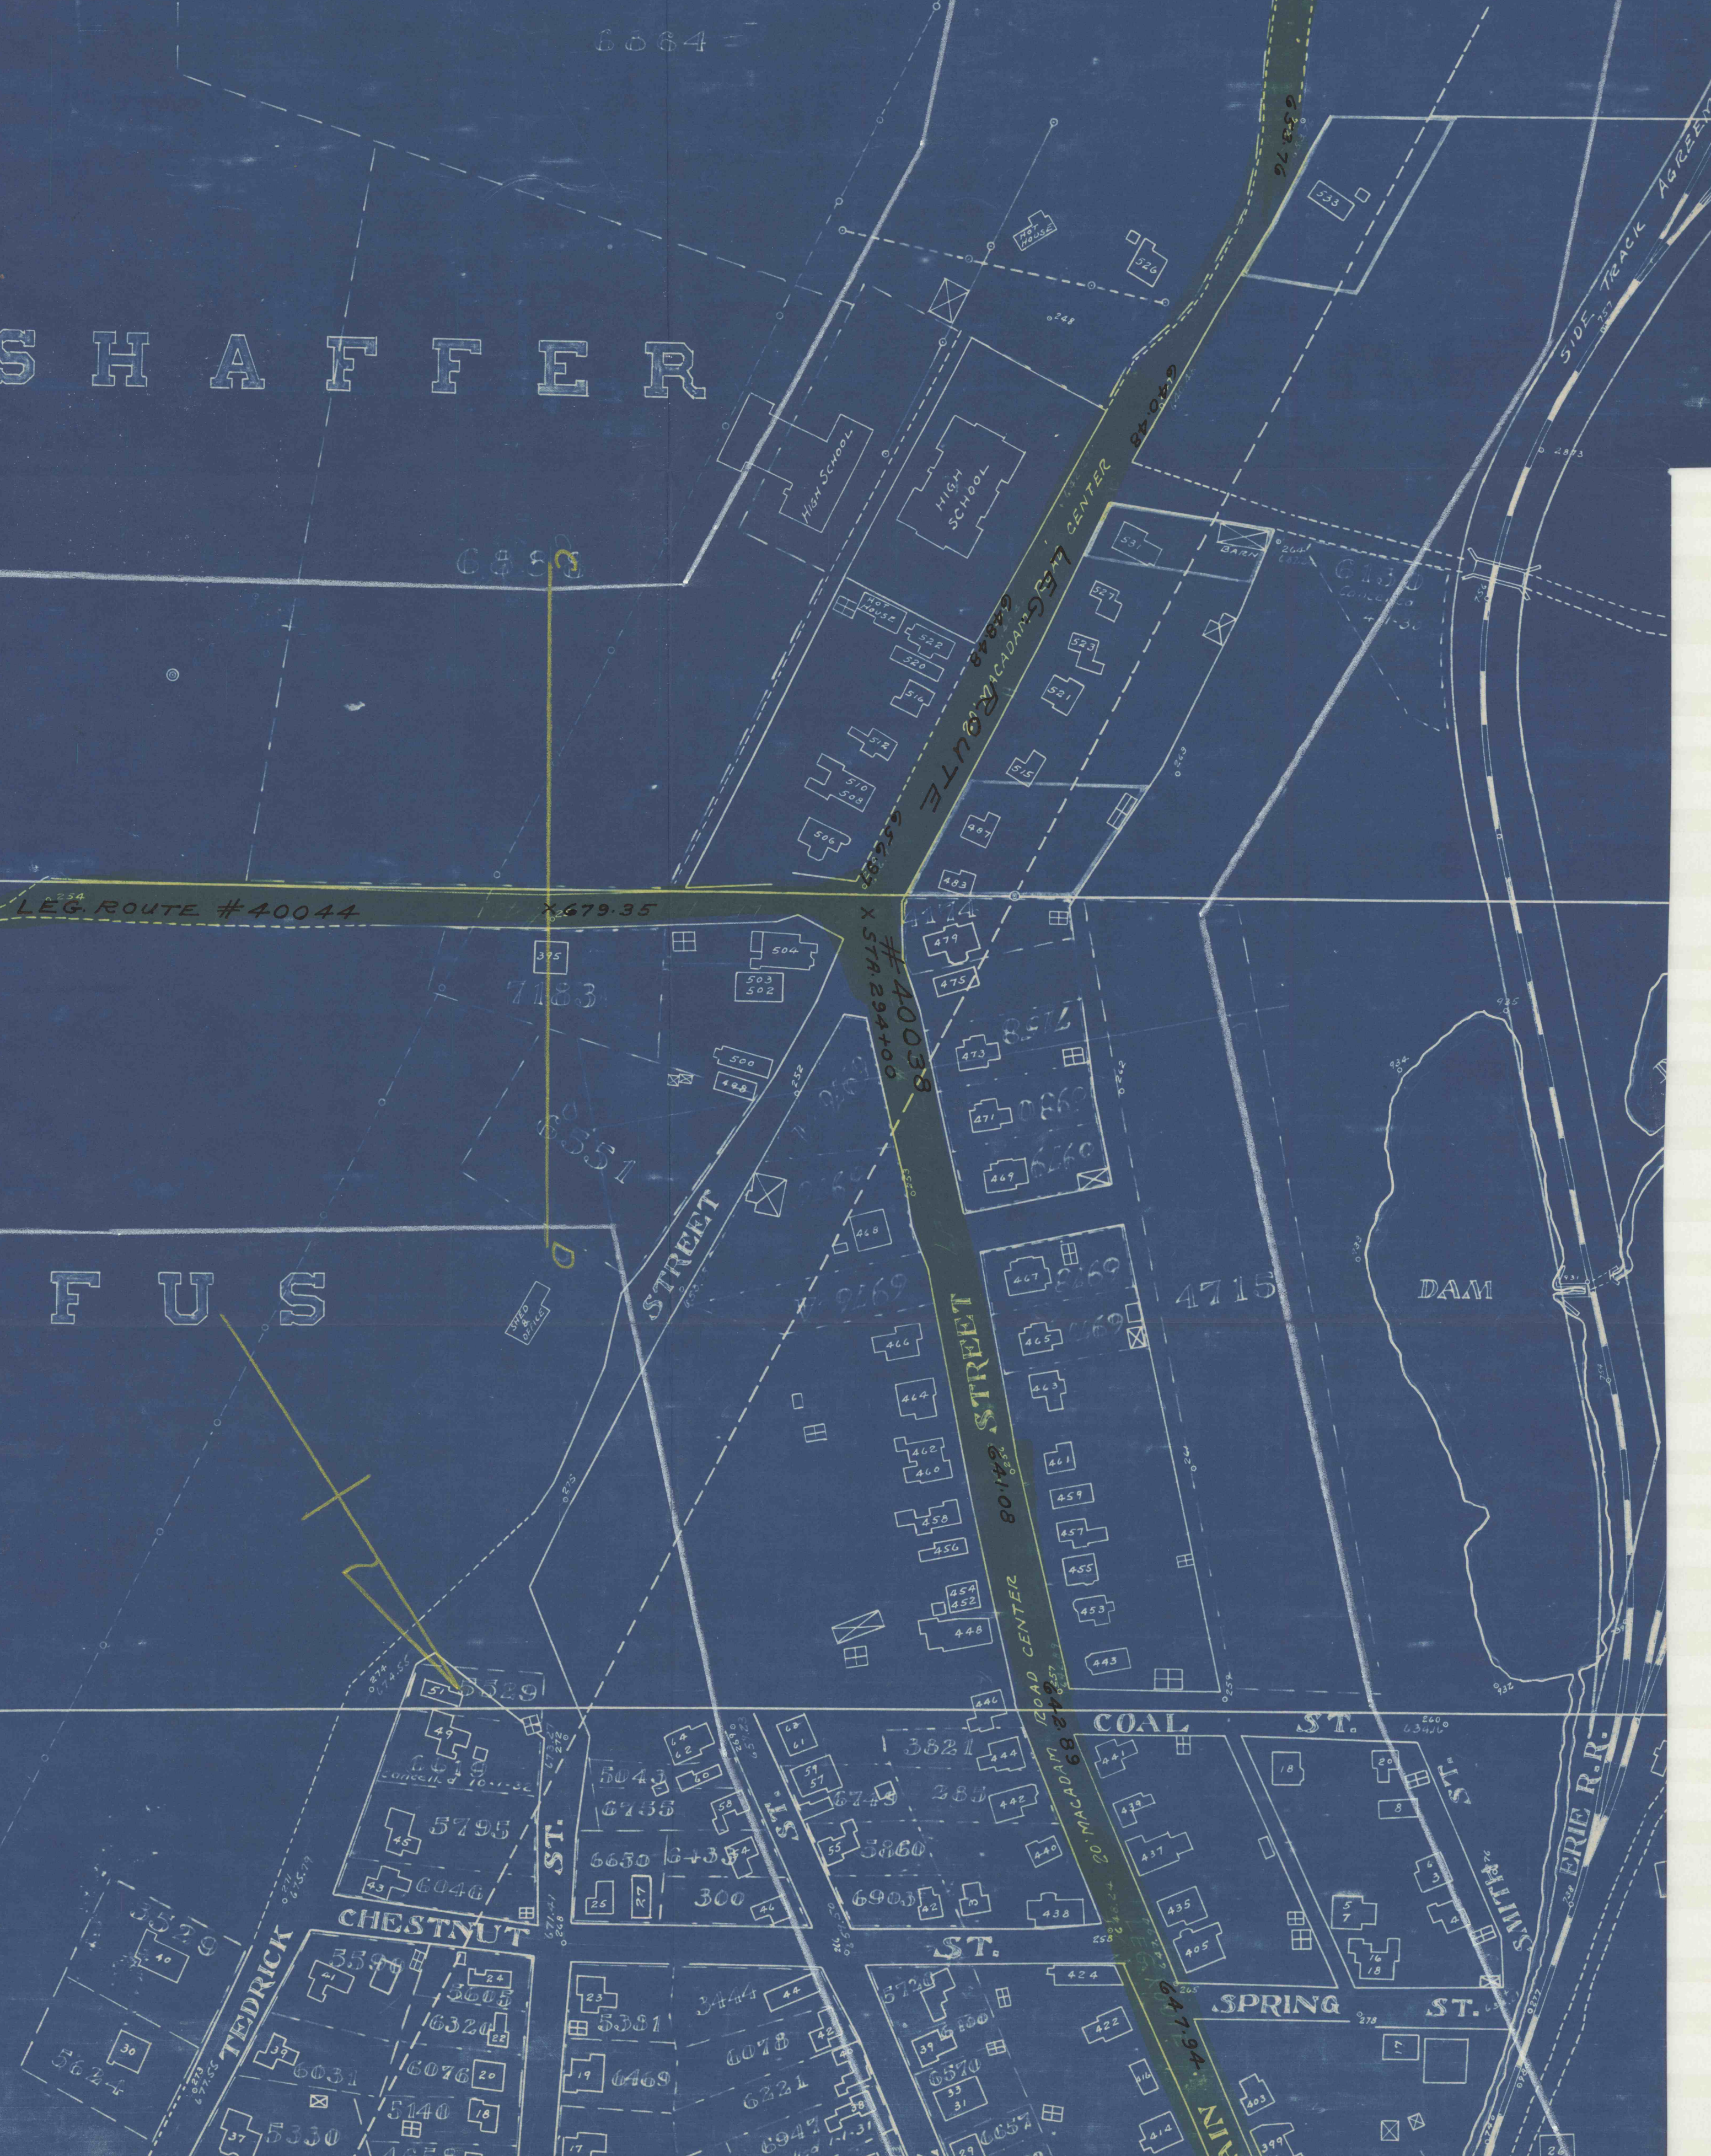

LEG ROUTE #4004

STATION #4003B

CHESTNUT STREET

TEDRICK STREET

SPRING ST.

COAL ST.

MAIN ST.

DAM

ERIE R.R.