

T

S

O

F

G

E

O

R

G

E

T


A

F

U

S

YATESVILLE TOWNSHIP  
JENKINS

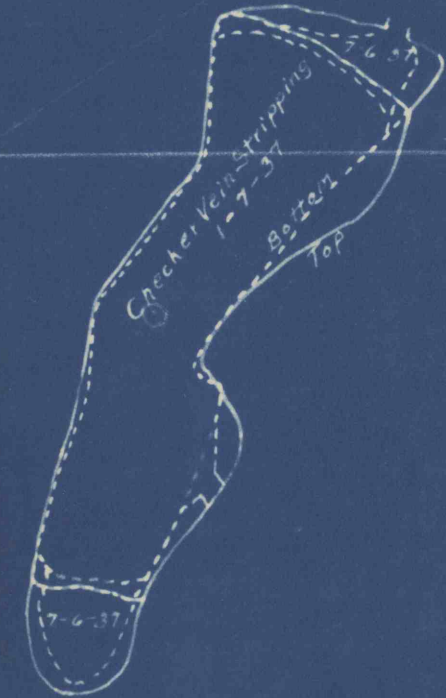

Top  
Bottom  
7-6-37

6888

N80-34W → 628.4

40044

750.96

7183

6551

STREET

40038

EWEN COLLIERY  
NO. 4 SHAFT - SURFACE  
Scale 1" = 100' 10-28-37  
Showing 40044 & 40038.