


T

S O F G E O R G E N A F U S

YATESVILLE TOWNSHIP
JENKINS

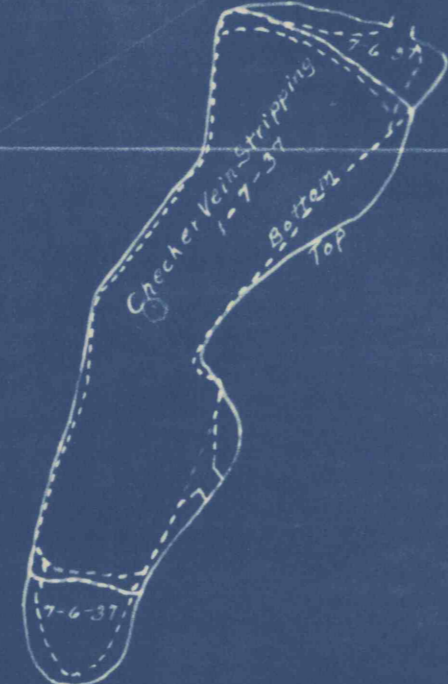

N80-34W → 628.4

APPROX 712.55 Surf

6888

40044

1342
750.96 @ P.P. STONE

7183

6551

STREET

40038



EVEN COLLIERY
NO. 4 SHAFT - SURFACE
Scale 1" = 100' 10-28-37
Showing 40044 & 40038.

TP
ESTABL
7-6-37