





SECTION A-B

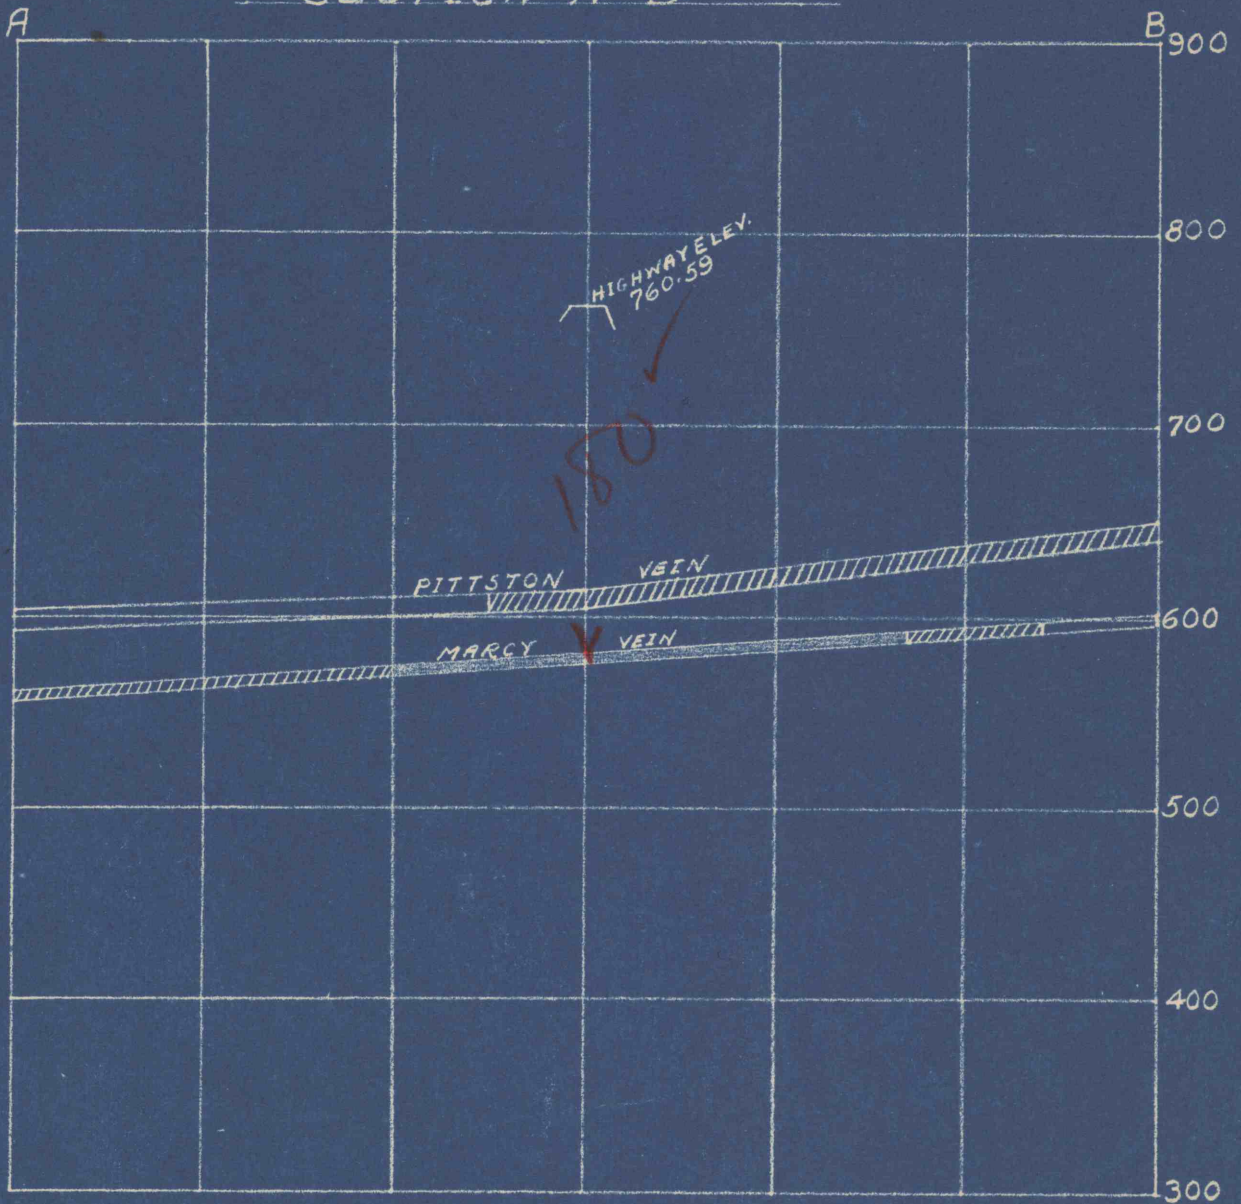

NO. 6 COLLIERY
 Coyer Slope - - - Marcy Vein
 Scale 1" = 100'

Cross section of Marcy Vein underlying Leg. Route #40044, Jenkins Twp., Luzerne County, Pa.

	Virgin coal
	First mined
	Mining completed