


SECTION C-D

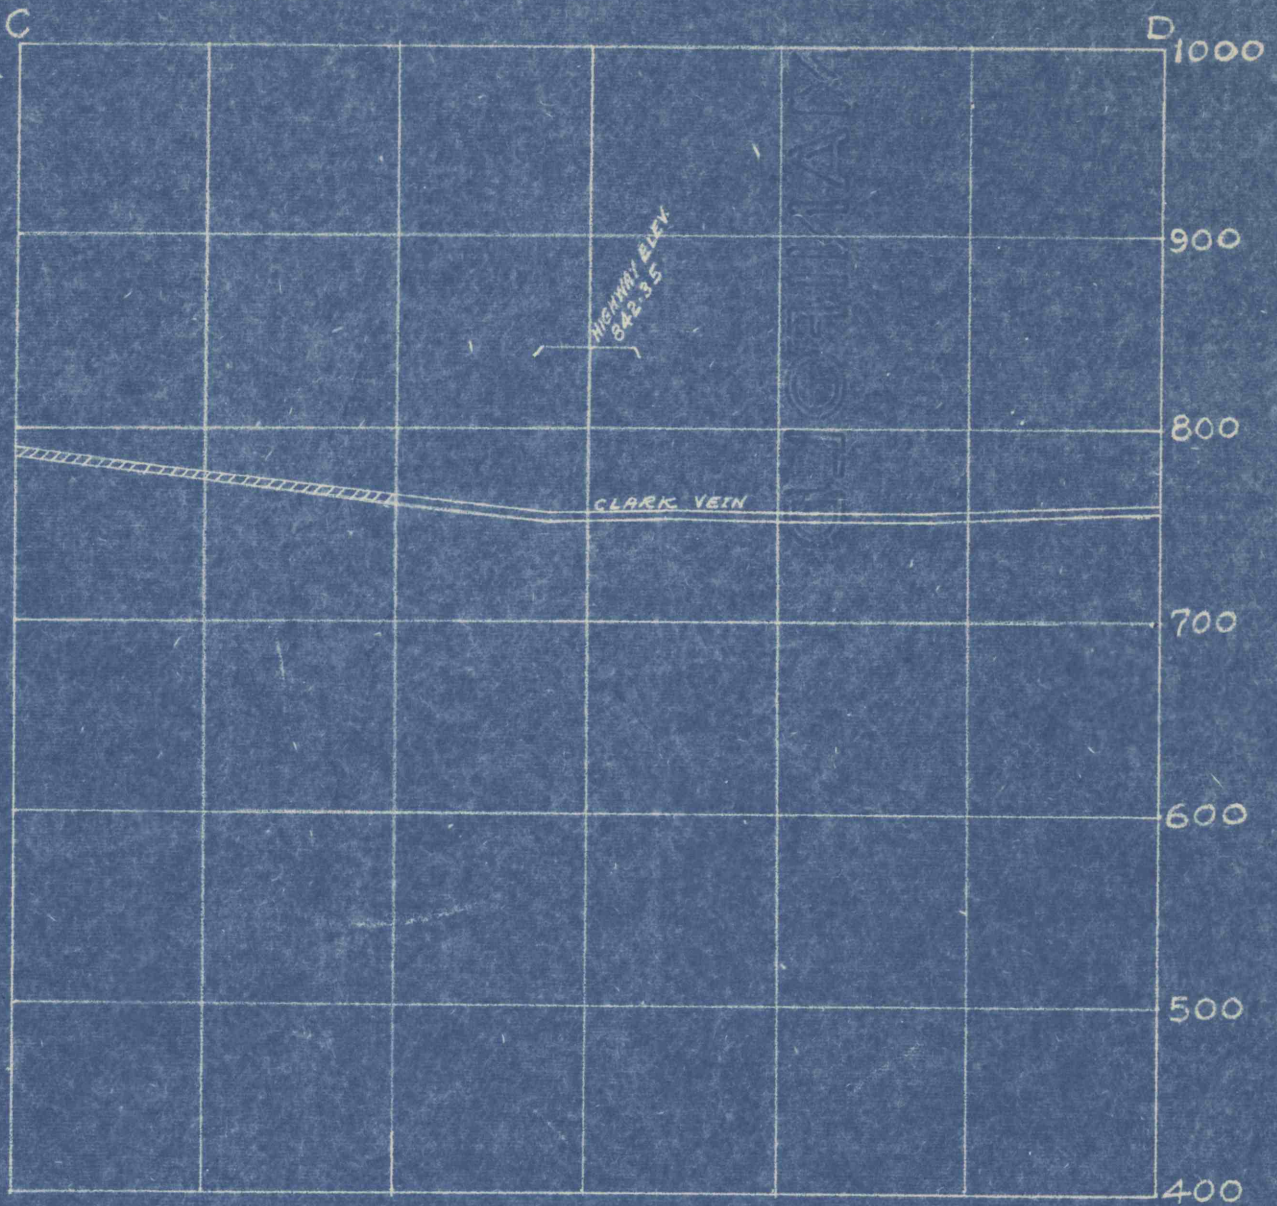

BUTLER COLLIERY
Capone Slope - - - Clark Vein
Scale 1" - 100'

Cross section of Clark Vein
underlying Leg. Route #40044
in Yatesville Borough, Luzerne
County, Pa.

▭ First mined
▨ Mining completed