


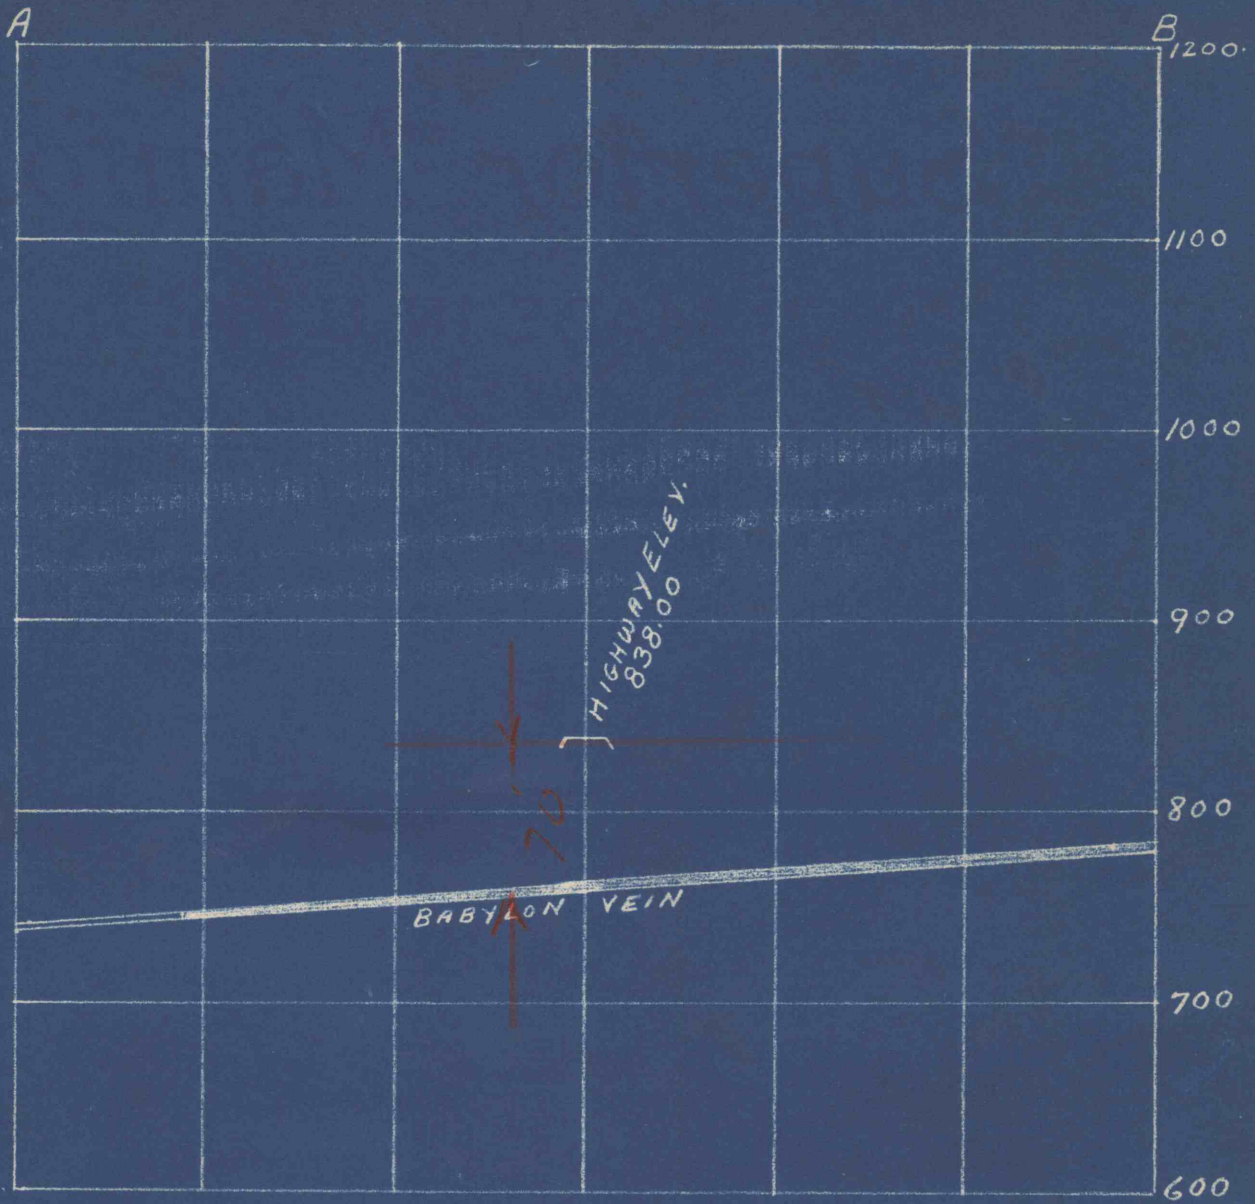


# SECTION A - B



BUTLER COLLIERY  
 Sarf Slope - - Babylon Vein  
 Scale 1" - 100'  
 Cross section of Babylon Vein  
 underlying Leg. Route No.40044  
 in Yatesville Borough, Luzerne  
 County, Pennsylvania.

-  Virgin Coal
-  First Mining
-  Mining completed