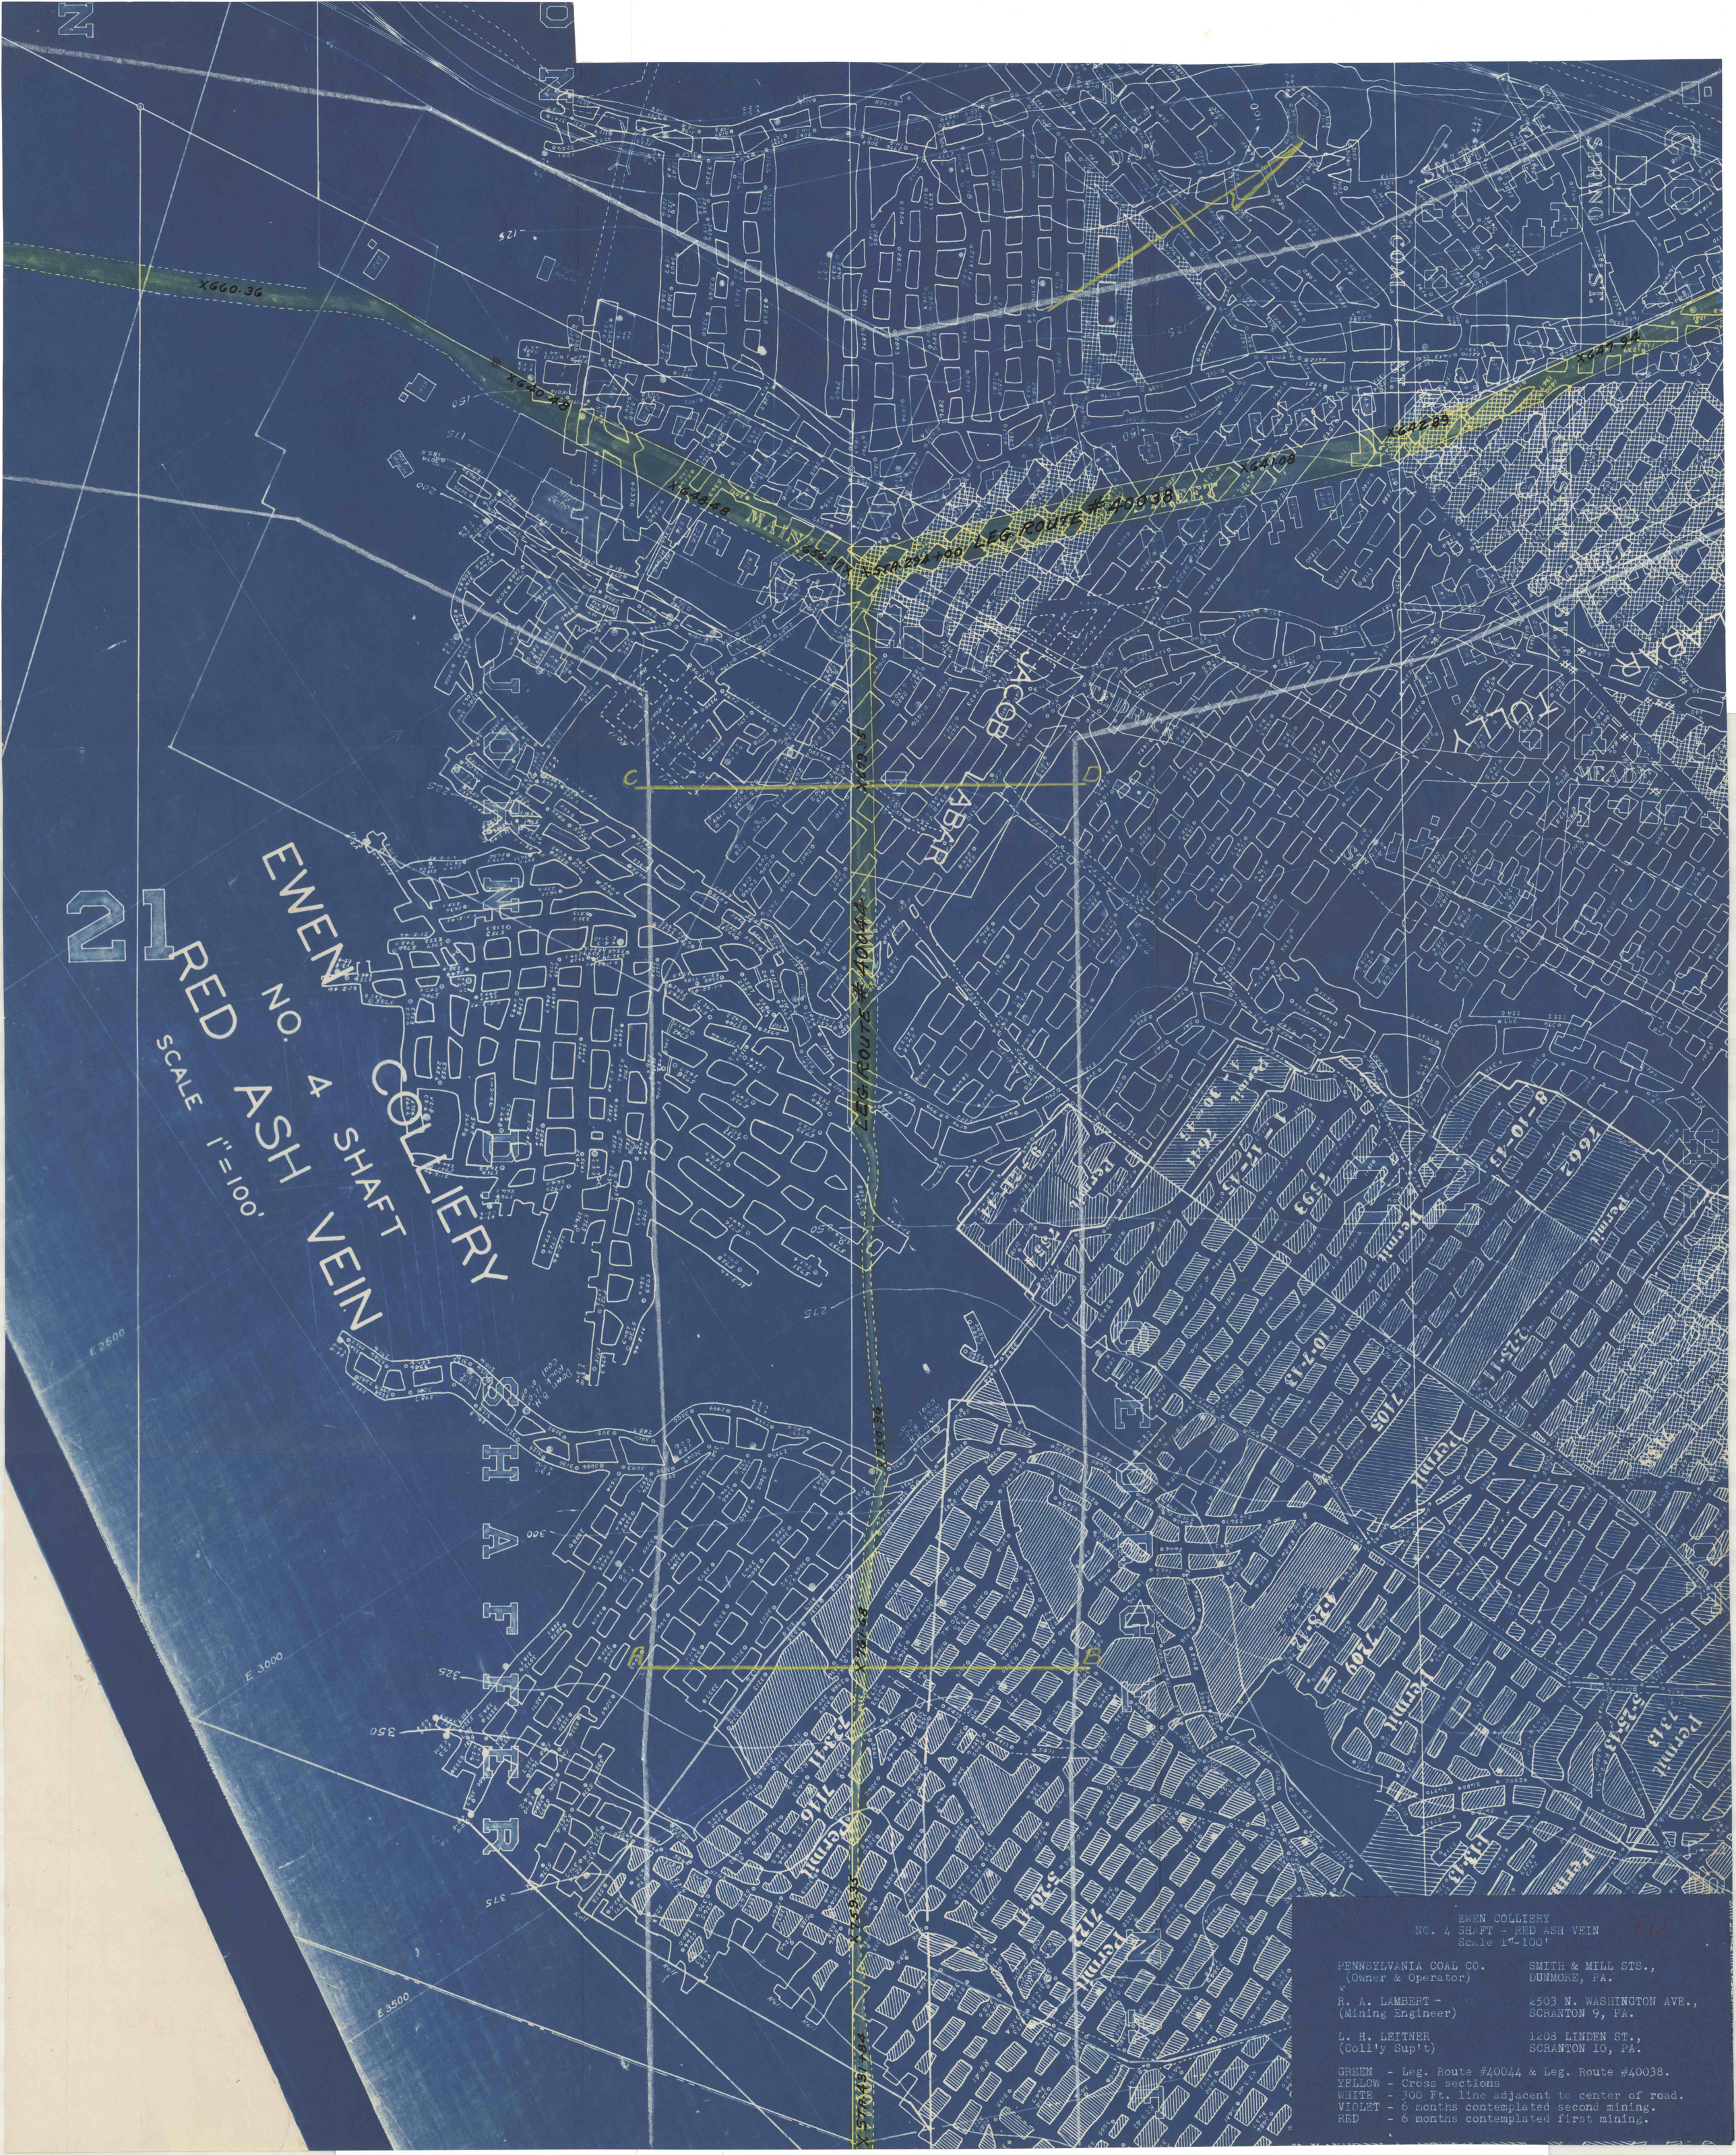
21
EWEN COLLIERY
NO. 4 SHAFT
RED ASH VEIN
SCALE 1"=100'
MAIN
LEFT
SPRING ST.
COAL
FOULEY
MEADE
LEG. ROUTE #40038
LEG. ROUTE #40044
X660.36
X648.48
X648.48
X642.89
X644.94
X644.08
X659.35
X659.35
X659.35