



SECTION C-D

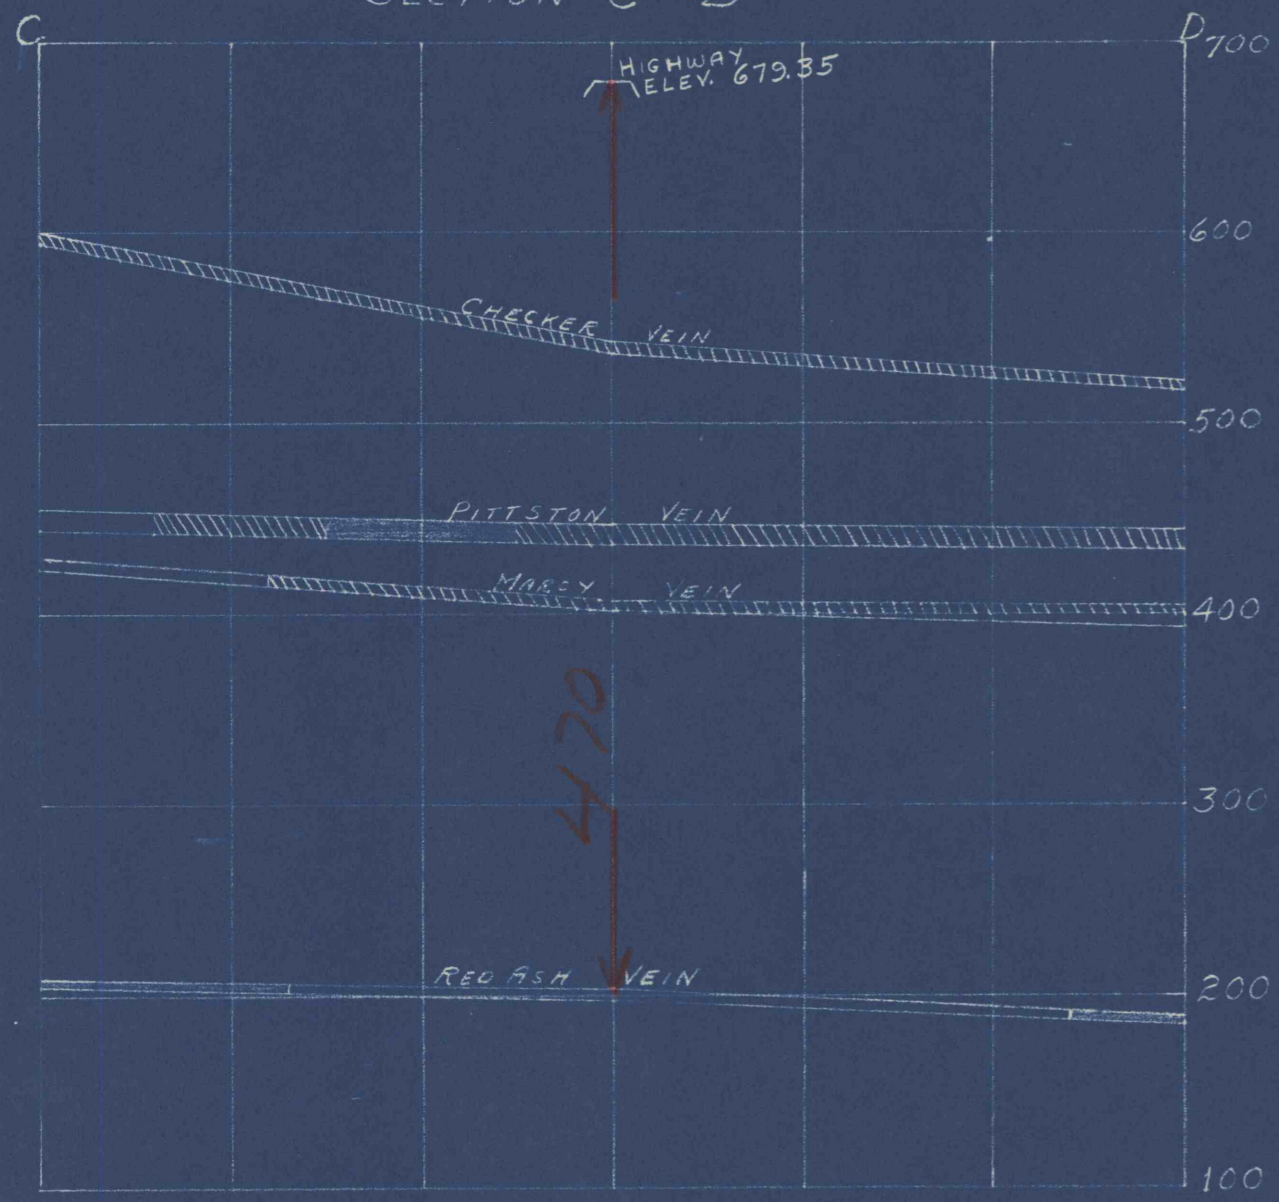




SECTION A-B

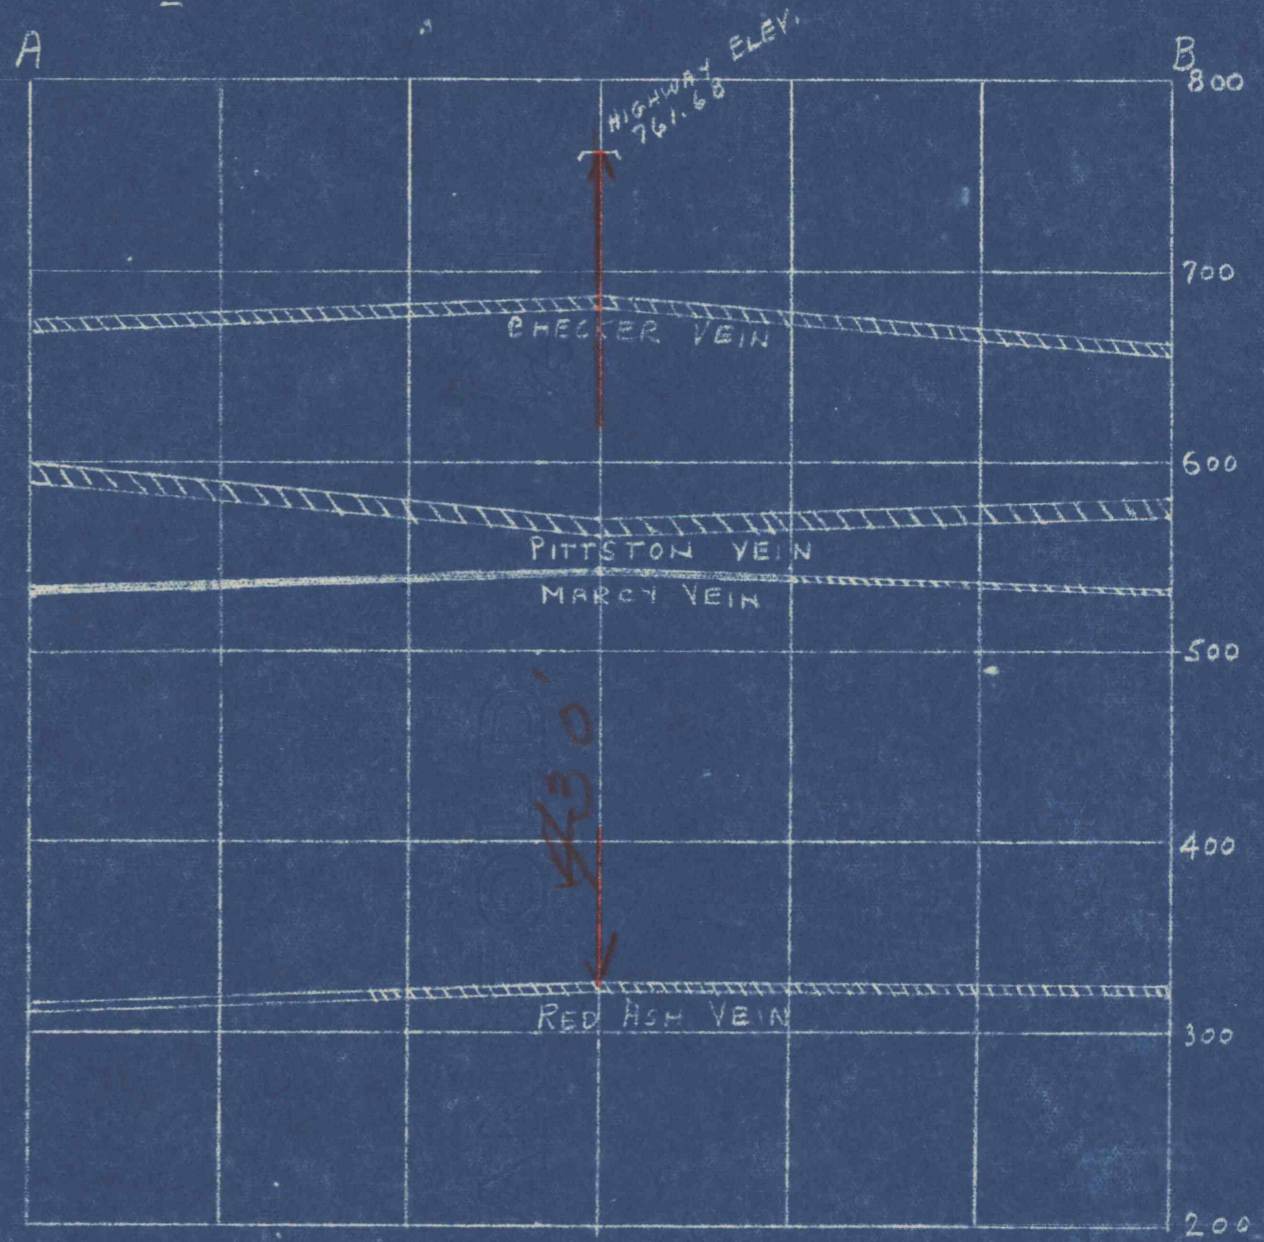

EWEN COLLIERY
 NO. 4 SHAFT - RED ASH VEIN
 Scale 1" = 100'

Cross section of Red Ash Vein,
 underlying Leg. Routes 40038 and
 40044, Jenkins Twp., Luzerne Co.,
 Pennsylvania

-  Virgin coal
-  First mined
-  Mining completed