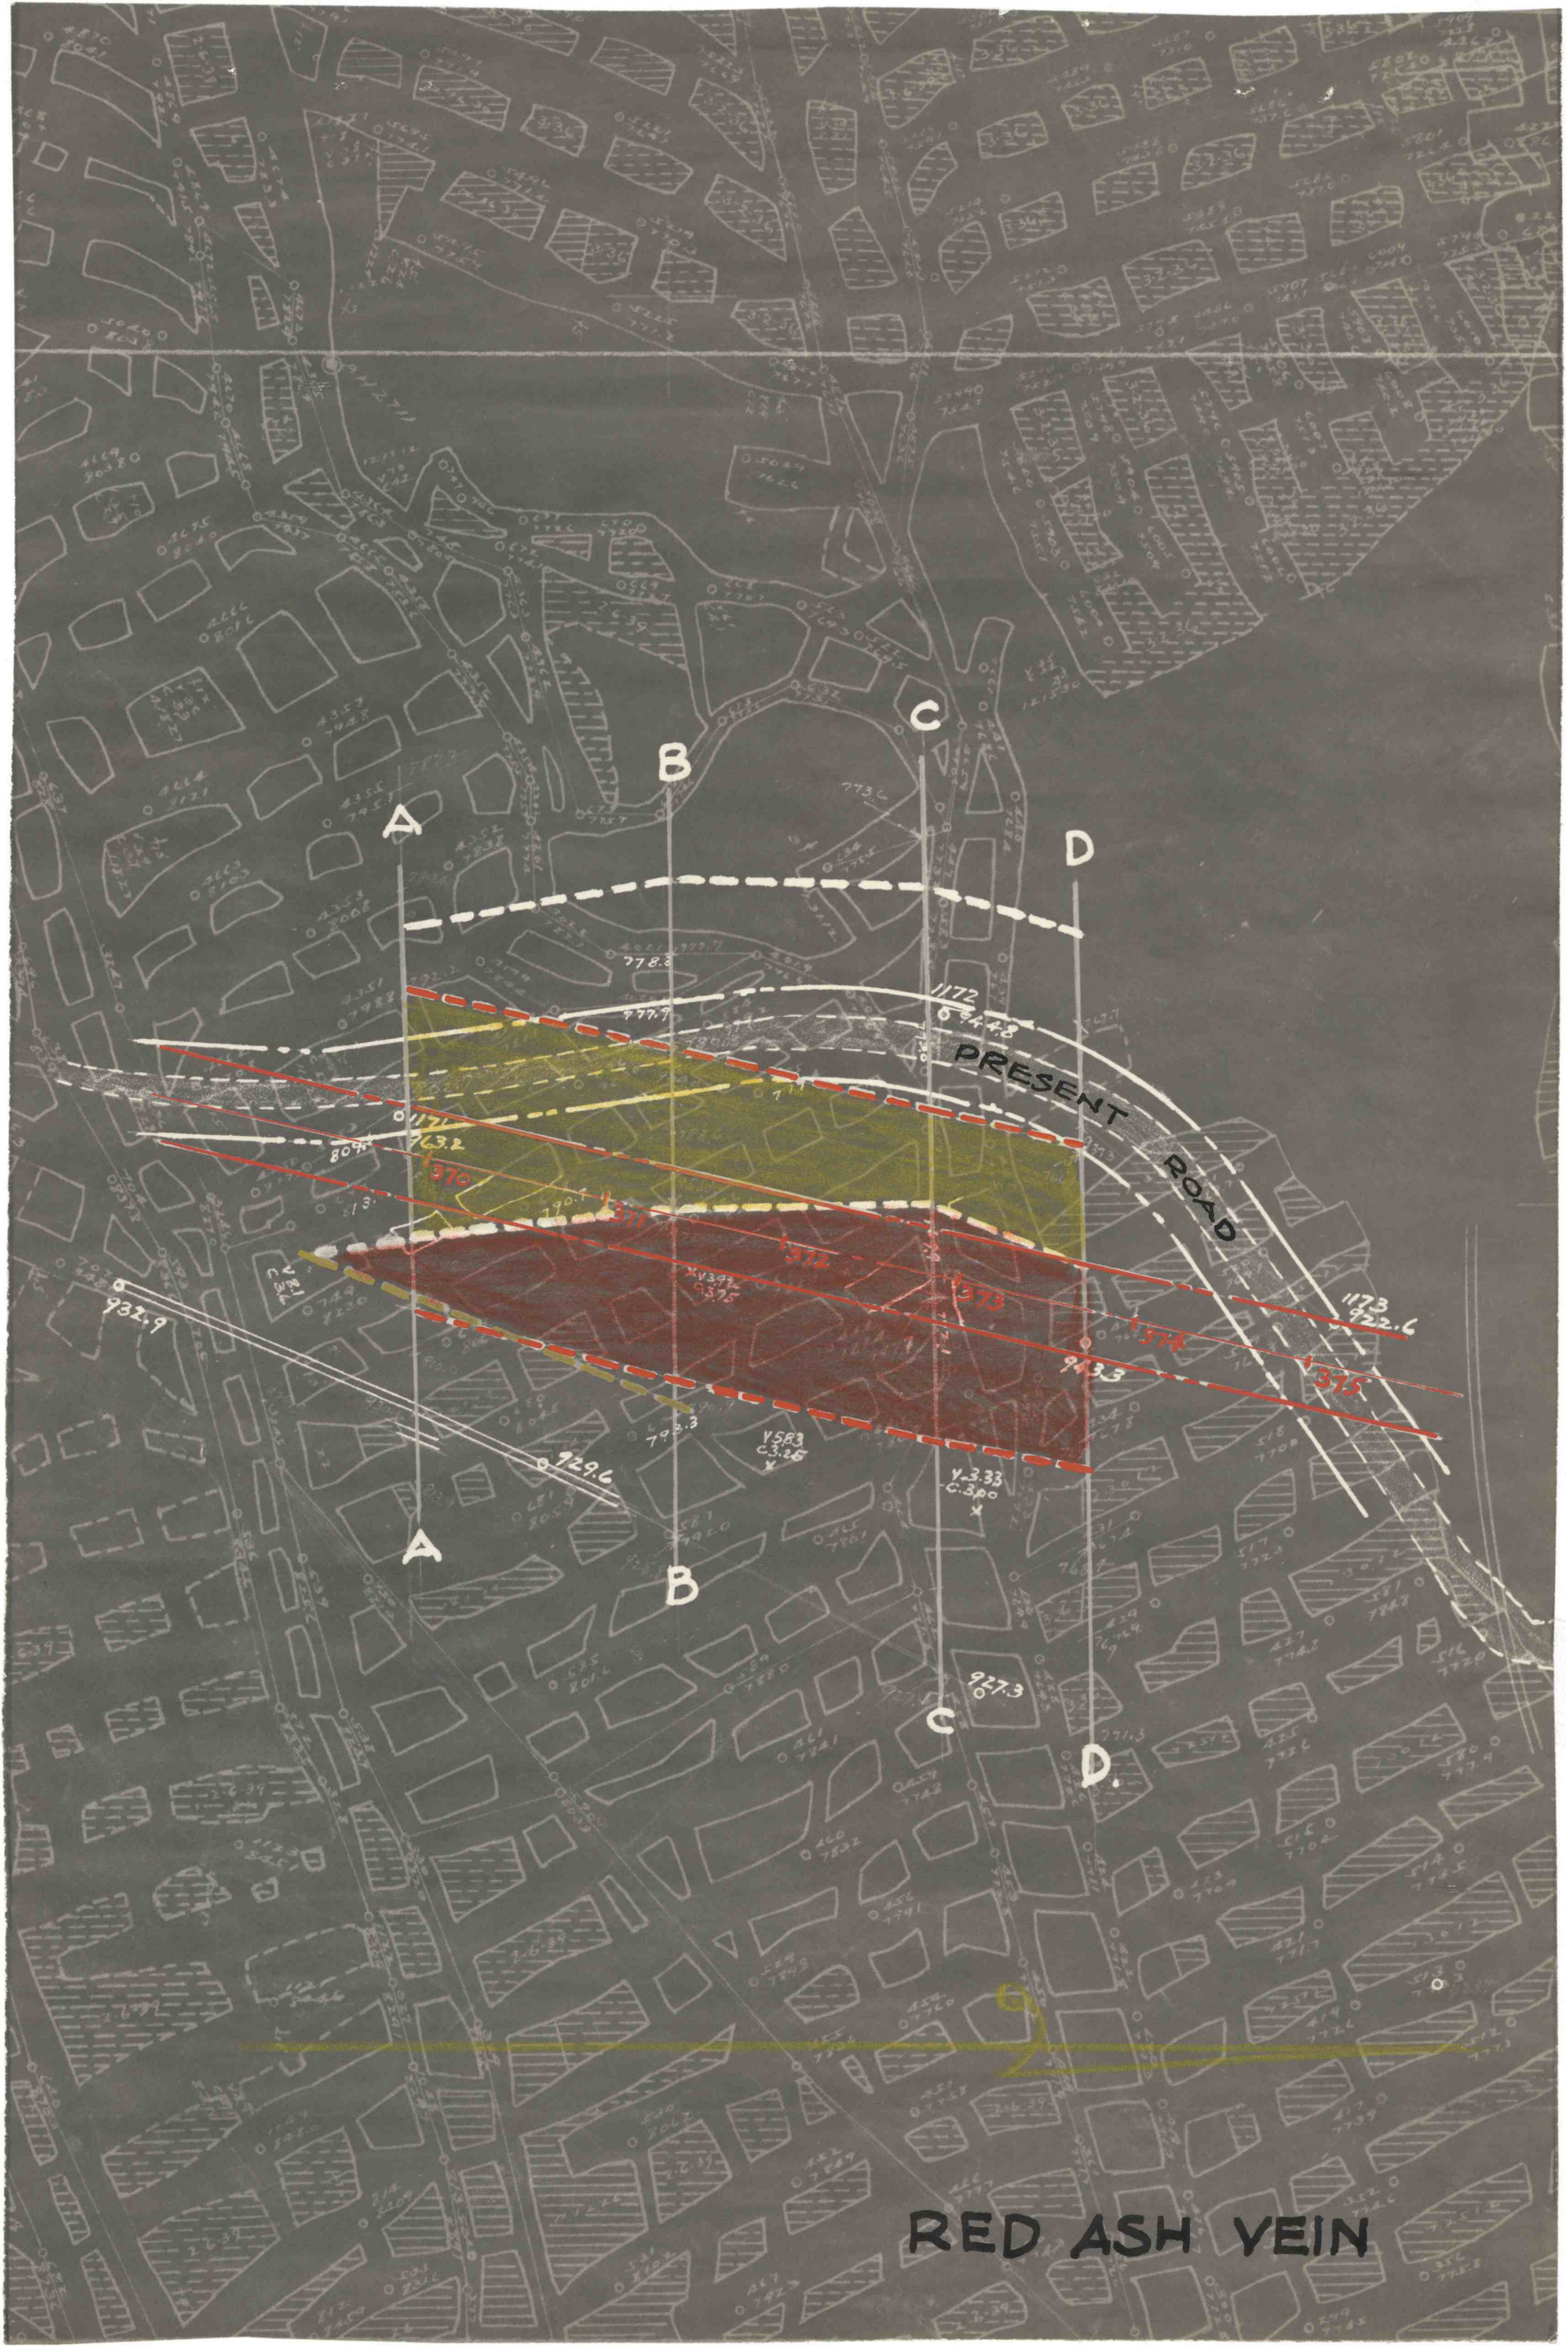
A
B
C
D
PRESENT
ROAD
370
371
372
373
374
375
932.9
929.6
927.3
A
B
C
D
RED ASH VEIN