
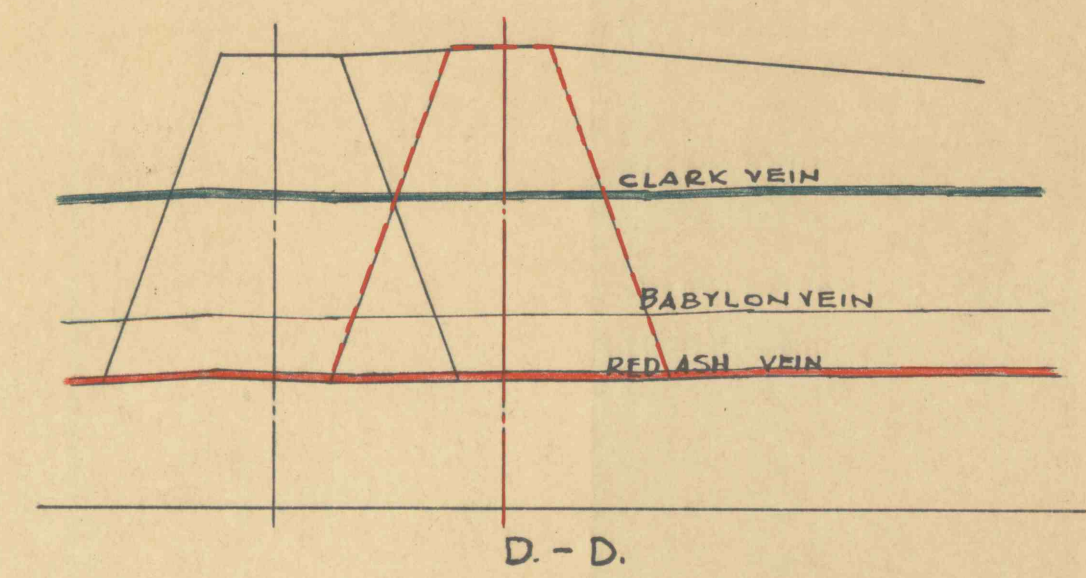


DATUM +700.

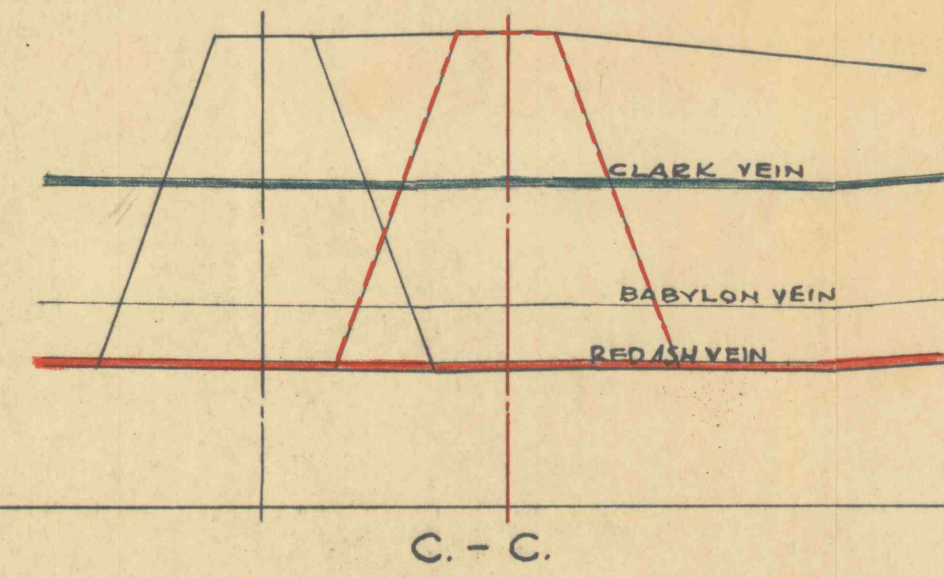

SECTIONS LOOKING NORTH
1" = 100'