

ROUTE

40038

← TO WILKES-BARRE

TO PITTSBURGH →


STA. 454+26

STA. 444+00

STA. 440+00

CRACK 1" WIDE

VILLAGE OF SEBASTOPOL

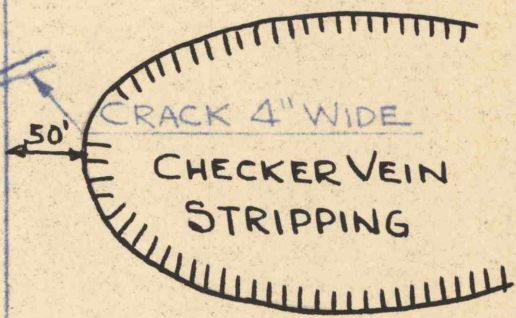

50'

CRACK 4" WIDE

CHECKER VEIN STRIPPING

JENKINS  
YATESVILLE

STA.  
431+84

TOWNSHIP  
BOROUGH

ROUTE 40044

← TO ROUTE 515

SKETCH  
OF SUBSIDENCE  
ON  
ROUTE 40044

6-25-46

⌘