


* Beginning at a point 900' Southeast from intersection of Scott & Mock Streets for a distance of 800 feet.

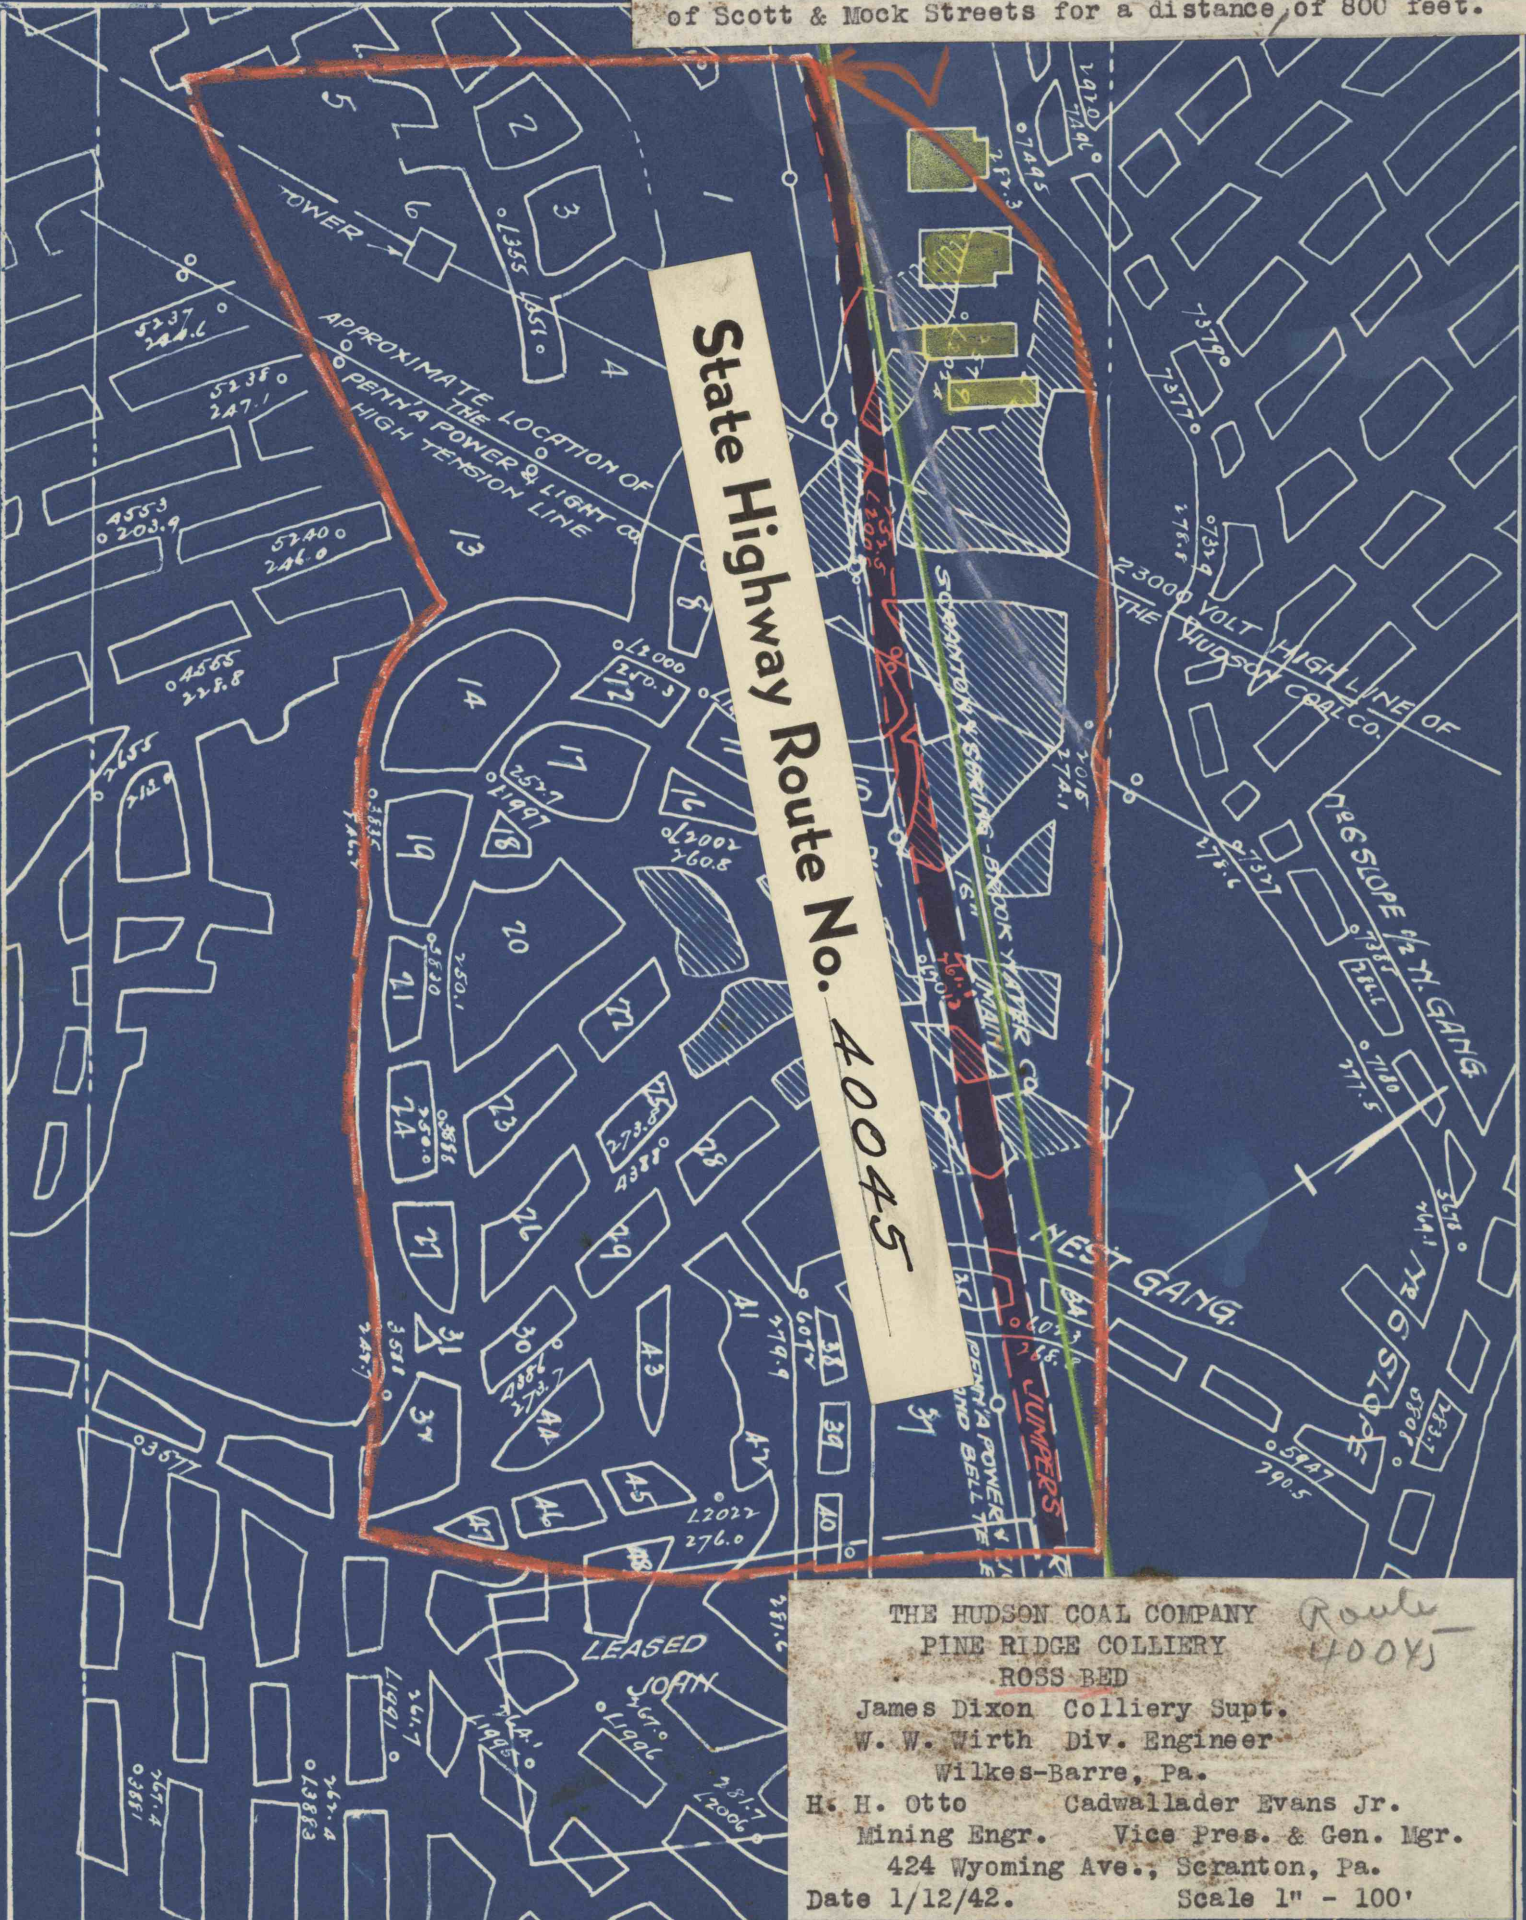

State Highway Route No. 40045

THE HUDSON COAL COMPANY *Route 40045*
 PINE RIDGE COLLIERY
 ROSS BED
 James Dixon Colliery Supt.
 W. W. Wirth Div. Engineer
 Wilkes-Barre, Pa.
 H. H. Otto Cadwallader Evans Jr.
 Mining Engr. Vice Pres. & Gen. Mgr.
 424 Wyoming Ave., Scranton, Pa.
 Date 1/12/42. Scale 1" - 100'