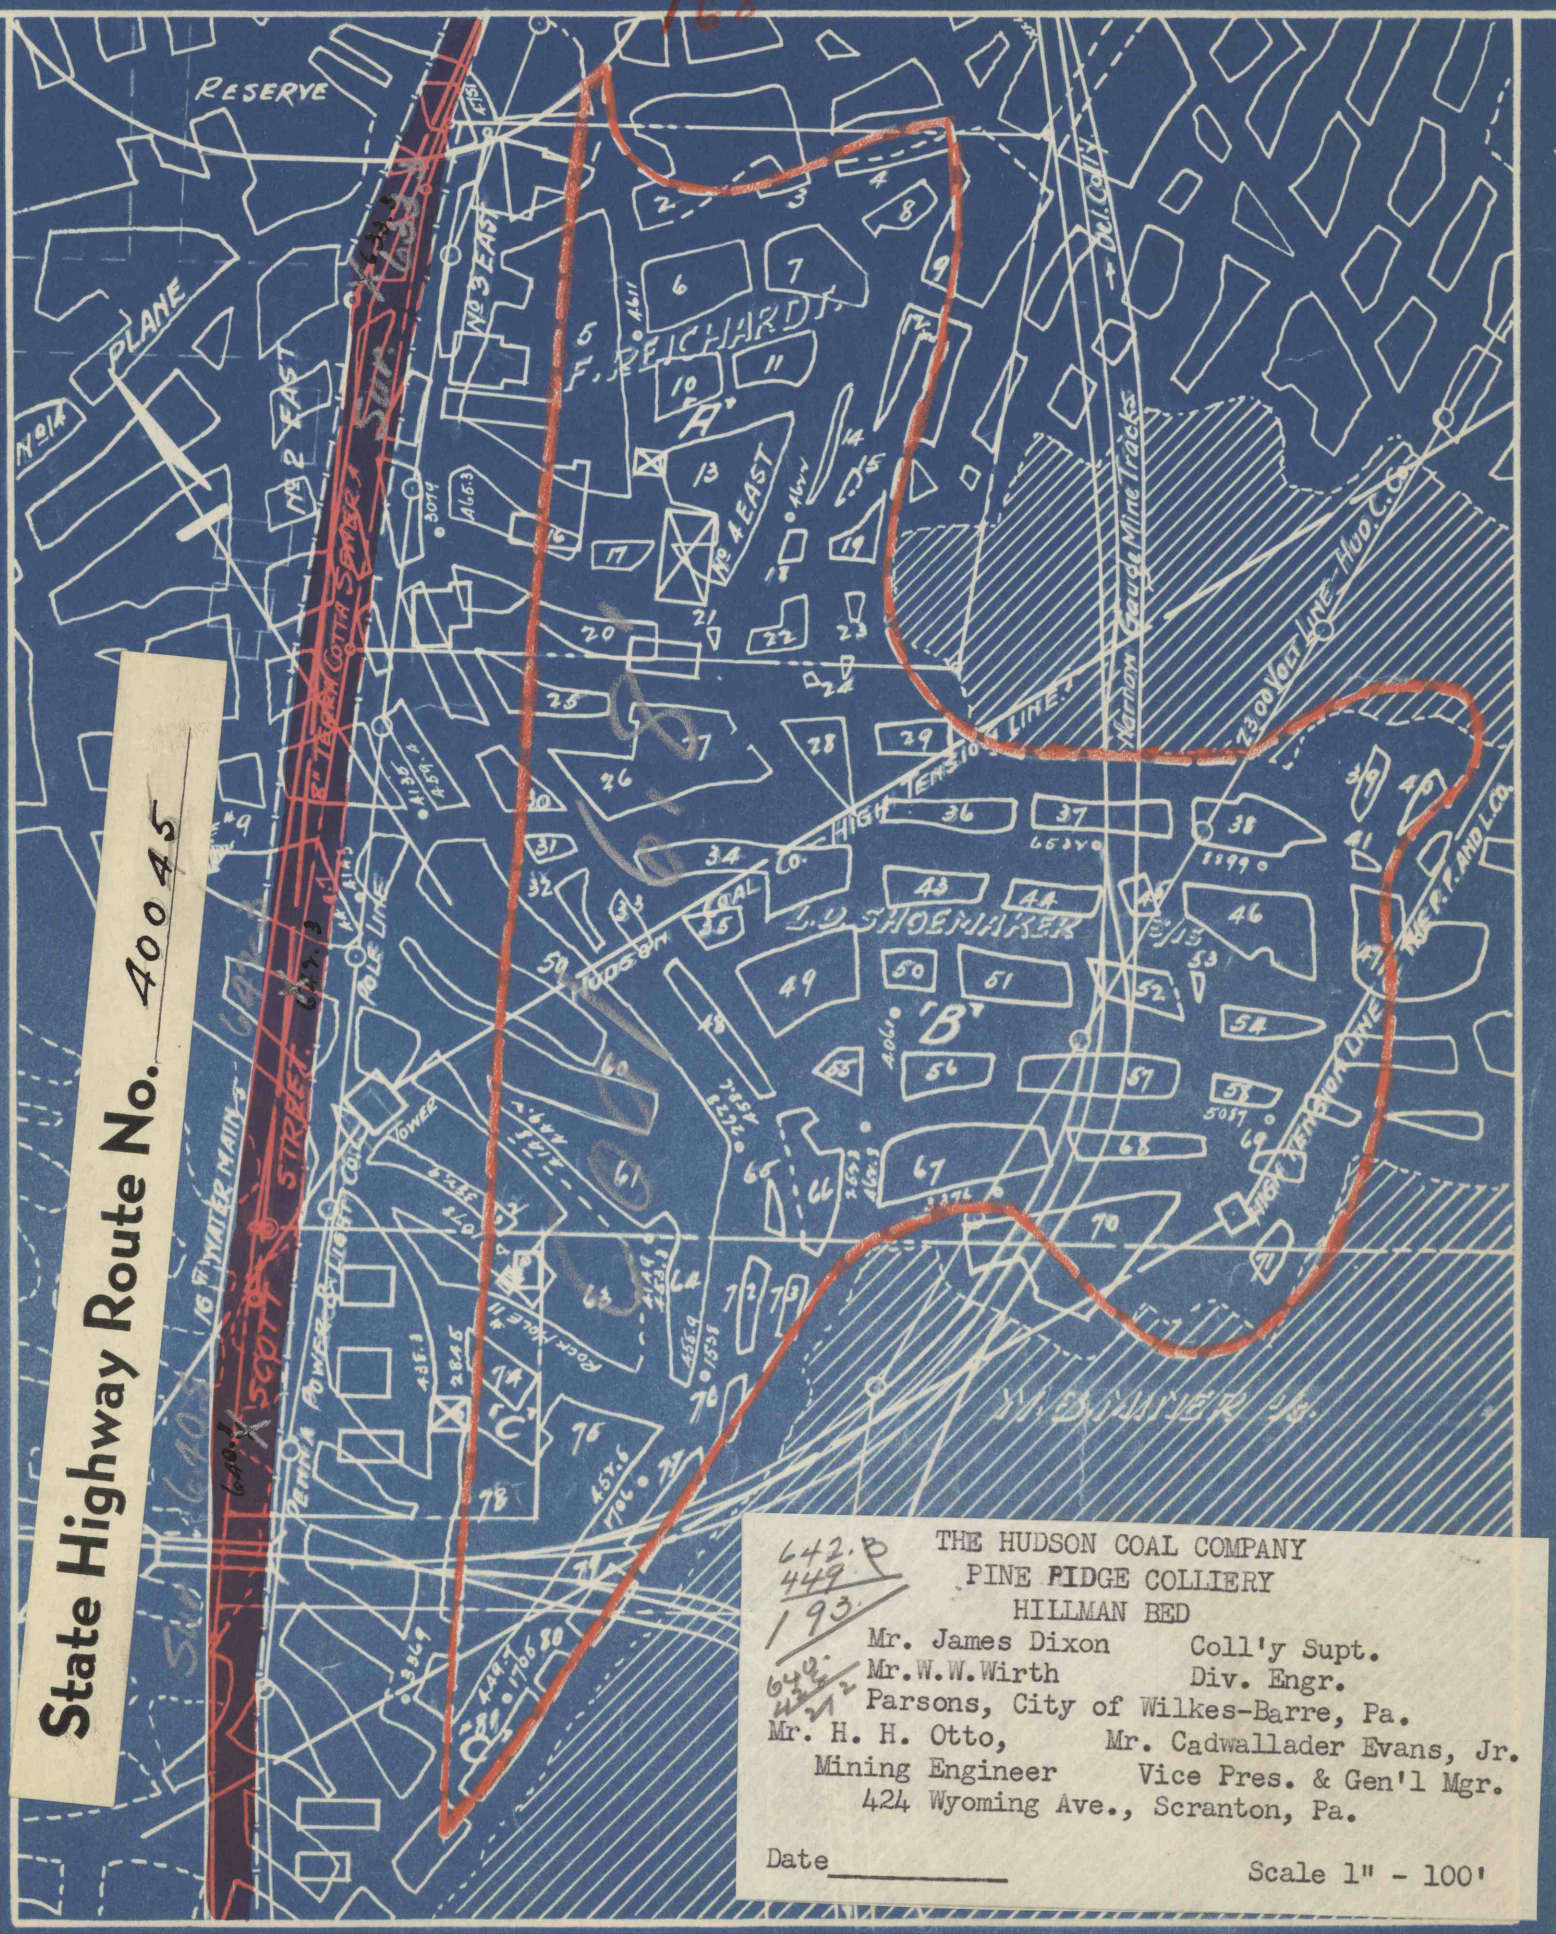

THE HUDSON COAL COMPANY
PINE RIDGE COLLIERY
HILLMAN BED

Mr. James Dixon — Coll'y Supt.
Mr. W. W. Wirth — Div. Engr.
Parsons, City of Wilkes-Barre, Pa.
Mr. H. H. Otto, Mining Engineer
Mr. Cadwallader Evans, Jr. Vice Pres. & Gen'l Mgr.
424 Wyoming Ave., Scranton, Pa.

Date_____ Scale 1" - 100'

642.8
449
193

642.8
449
1/2

#379 - P.R. Hillman (5)