


Sur.
633.3 x
SCOTT

STREET #40045
Sur.
2670.1

State Highway Route No. 40045

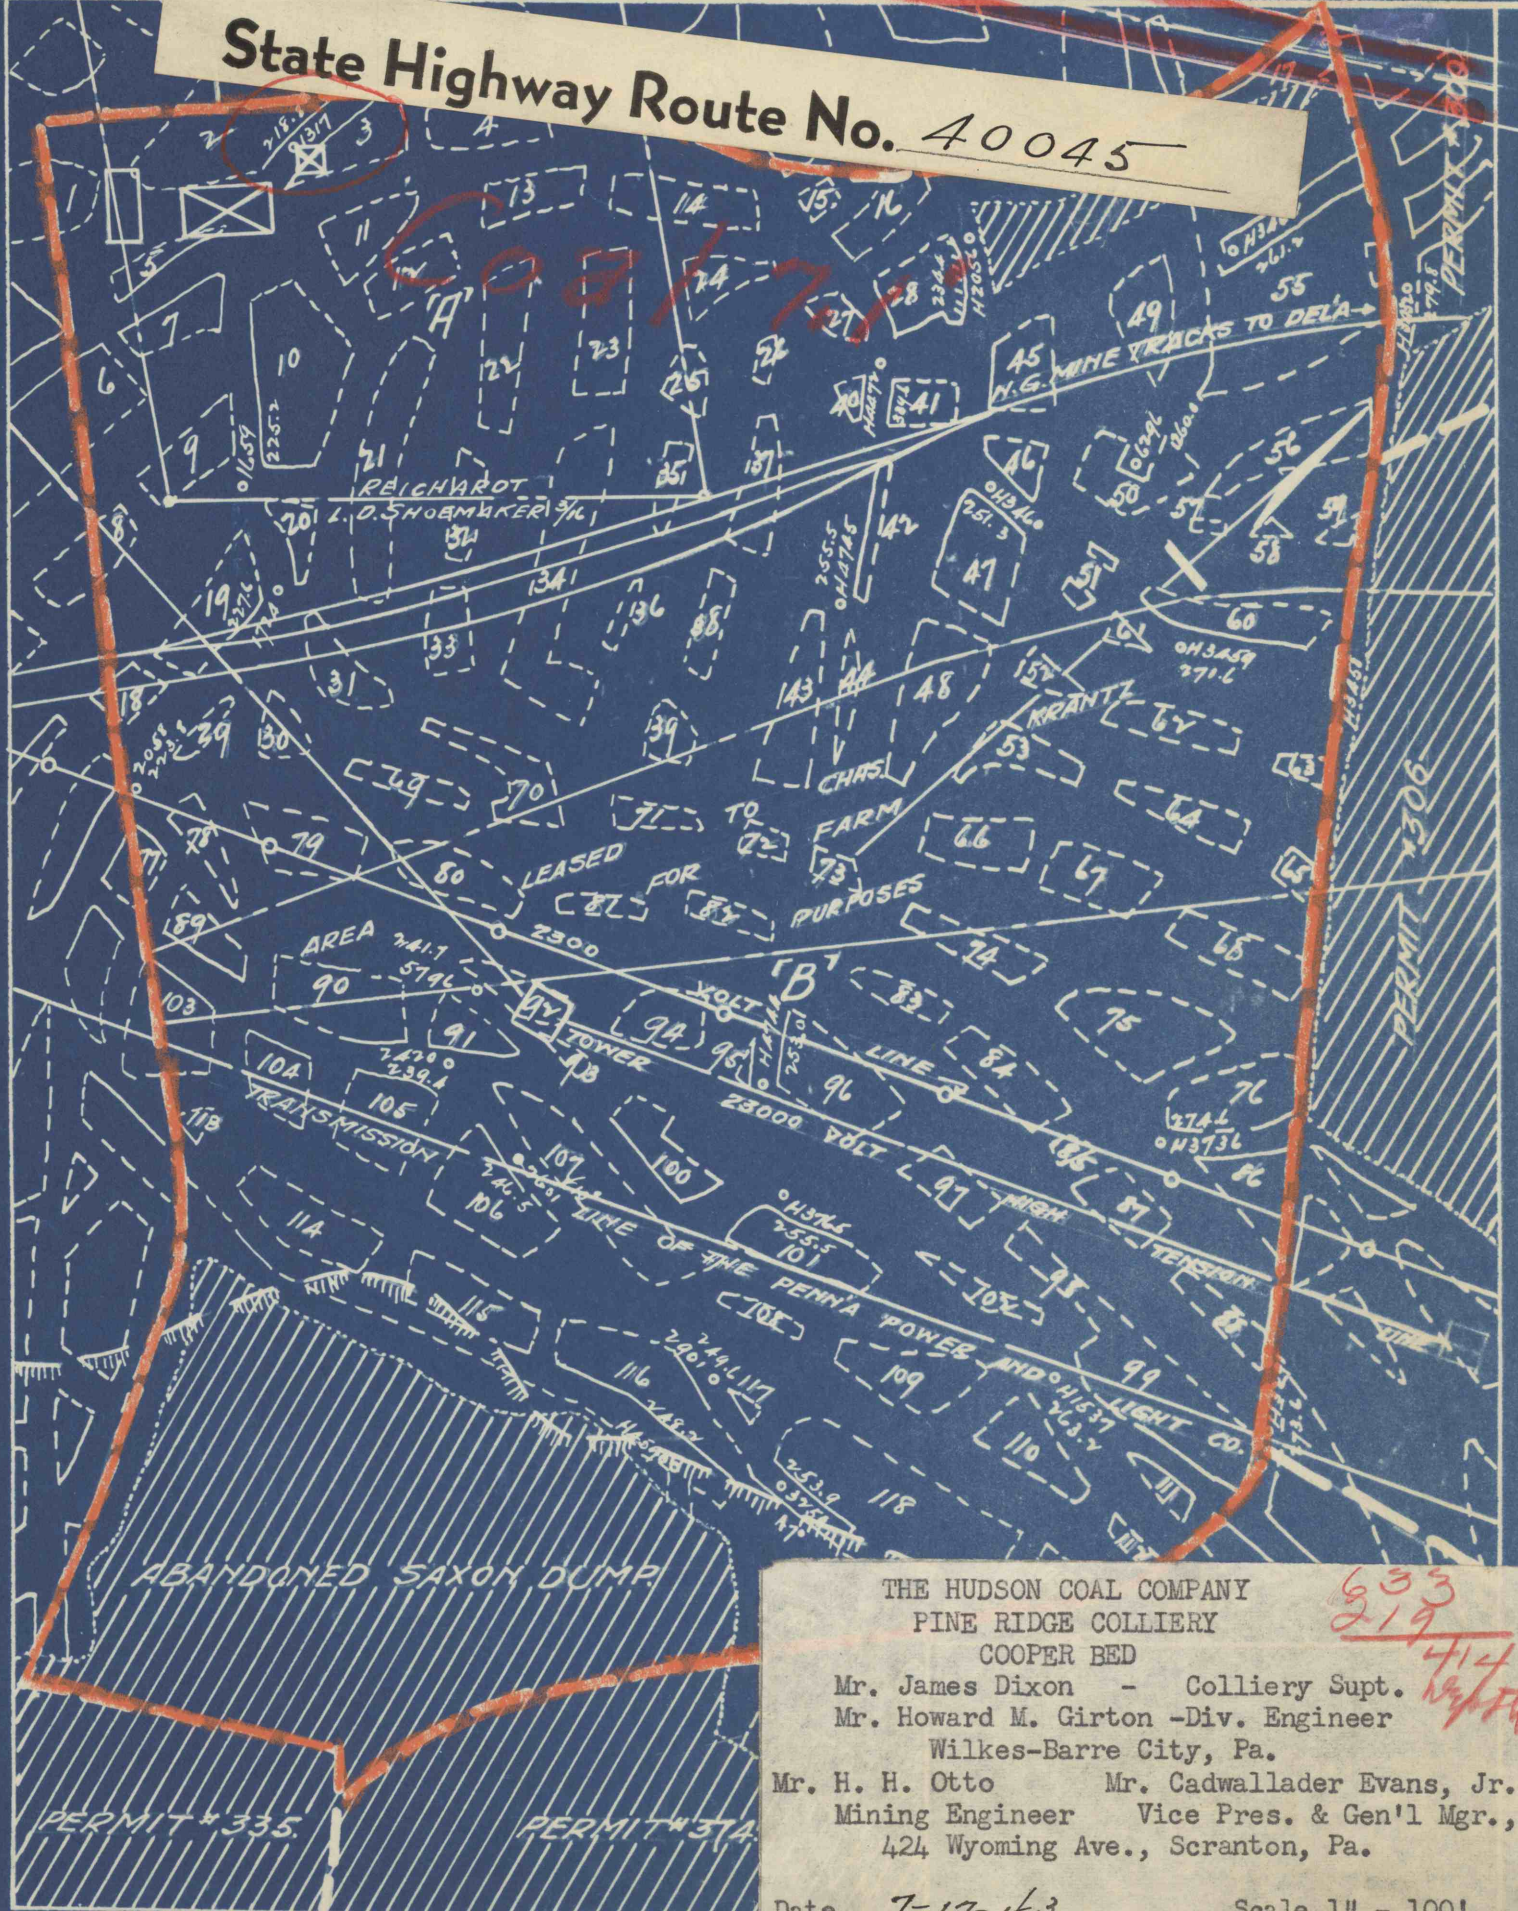

THE HUDSON COAL COMPANY
 PINE RIDGE COLLIERY
 COOPER BED
 Mr. James Dixon - Colliery Supt.
 Mr. Howard M. Girton - Div. Engineer
 Wilkes-Barre City, Pa.
 Mr. H. H. Otto Mr. Cadwallader Evans, Jr.
 Mining Engineer Vice Pres. & Gen'l Mgr.,
 424 Wyoming Ave., Scranton, Pa.

633
219
414
12/17/43

Date 7-17-43 Scale 1" - 100'