


State Highway Route No. 40045

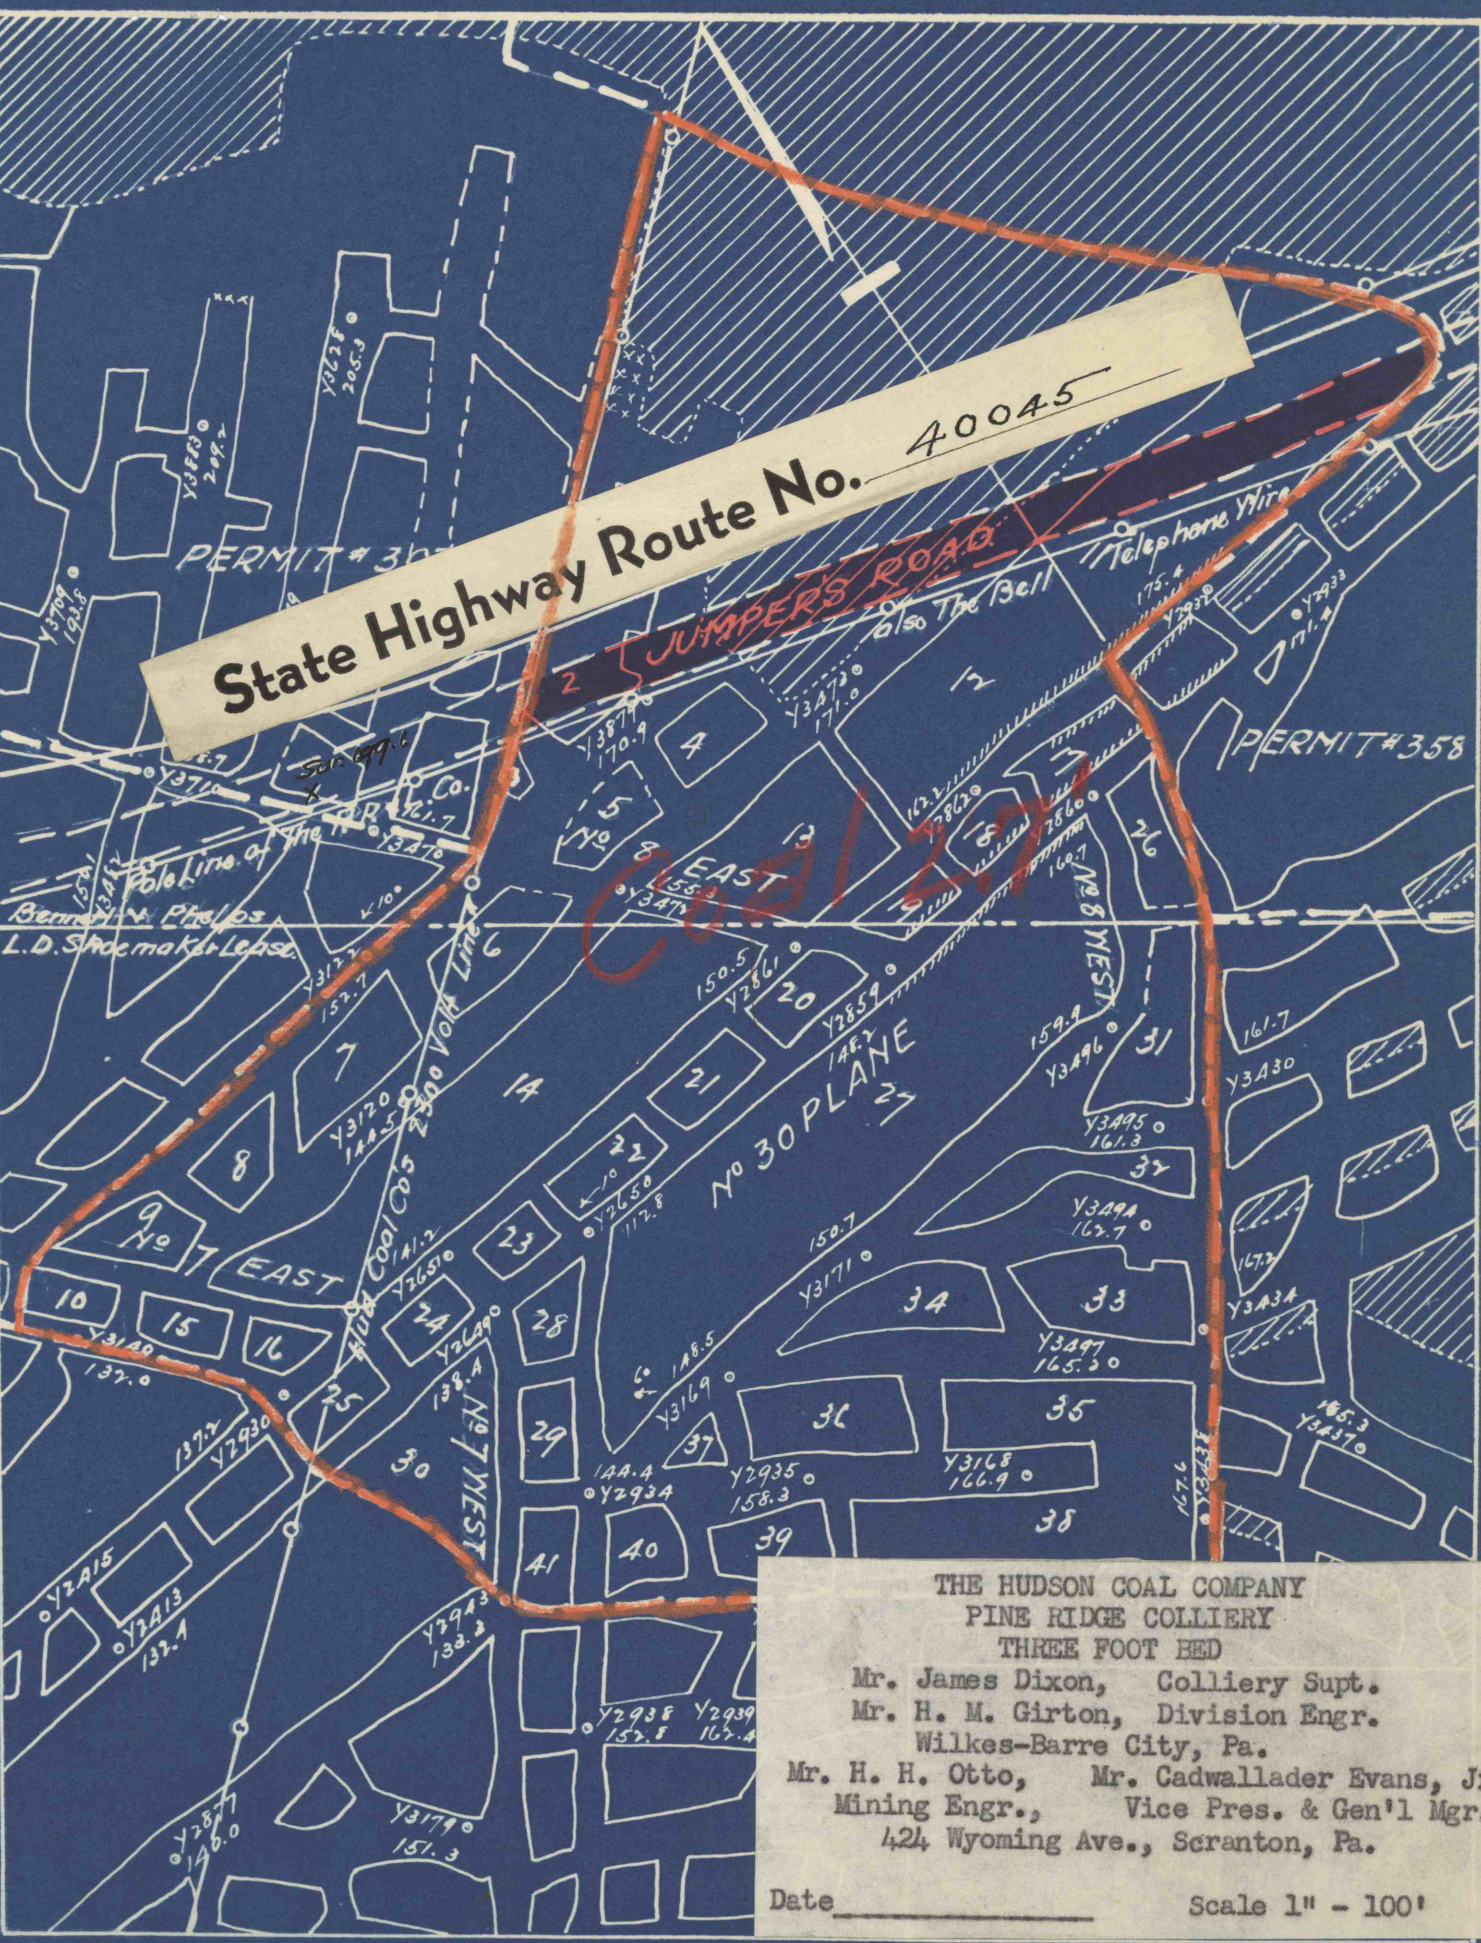

THE HUDSON COAL COMPANY
PINE RIDGE COLLIERY
THREE FOOT BED

Mr. James Dixon, Colliery Supt.
Mr. H. M. Girton, Division Engr.
Wilkes-Barre City, Pa.
Mr. H. H. Otto, Mr. Cadwallader Evans, Jr.
Mining Engr., Vice Pres. & Gen'l Mgr.,
424 Wyoming Ave., Scranton, Pa.

Date _____ Scale 1" = 100'