


MINERAL SPRING COAL CO.

MINERAL SPRING COAL CO.

HUDSON COAL CO.

HUDSON COAL CO.

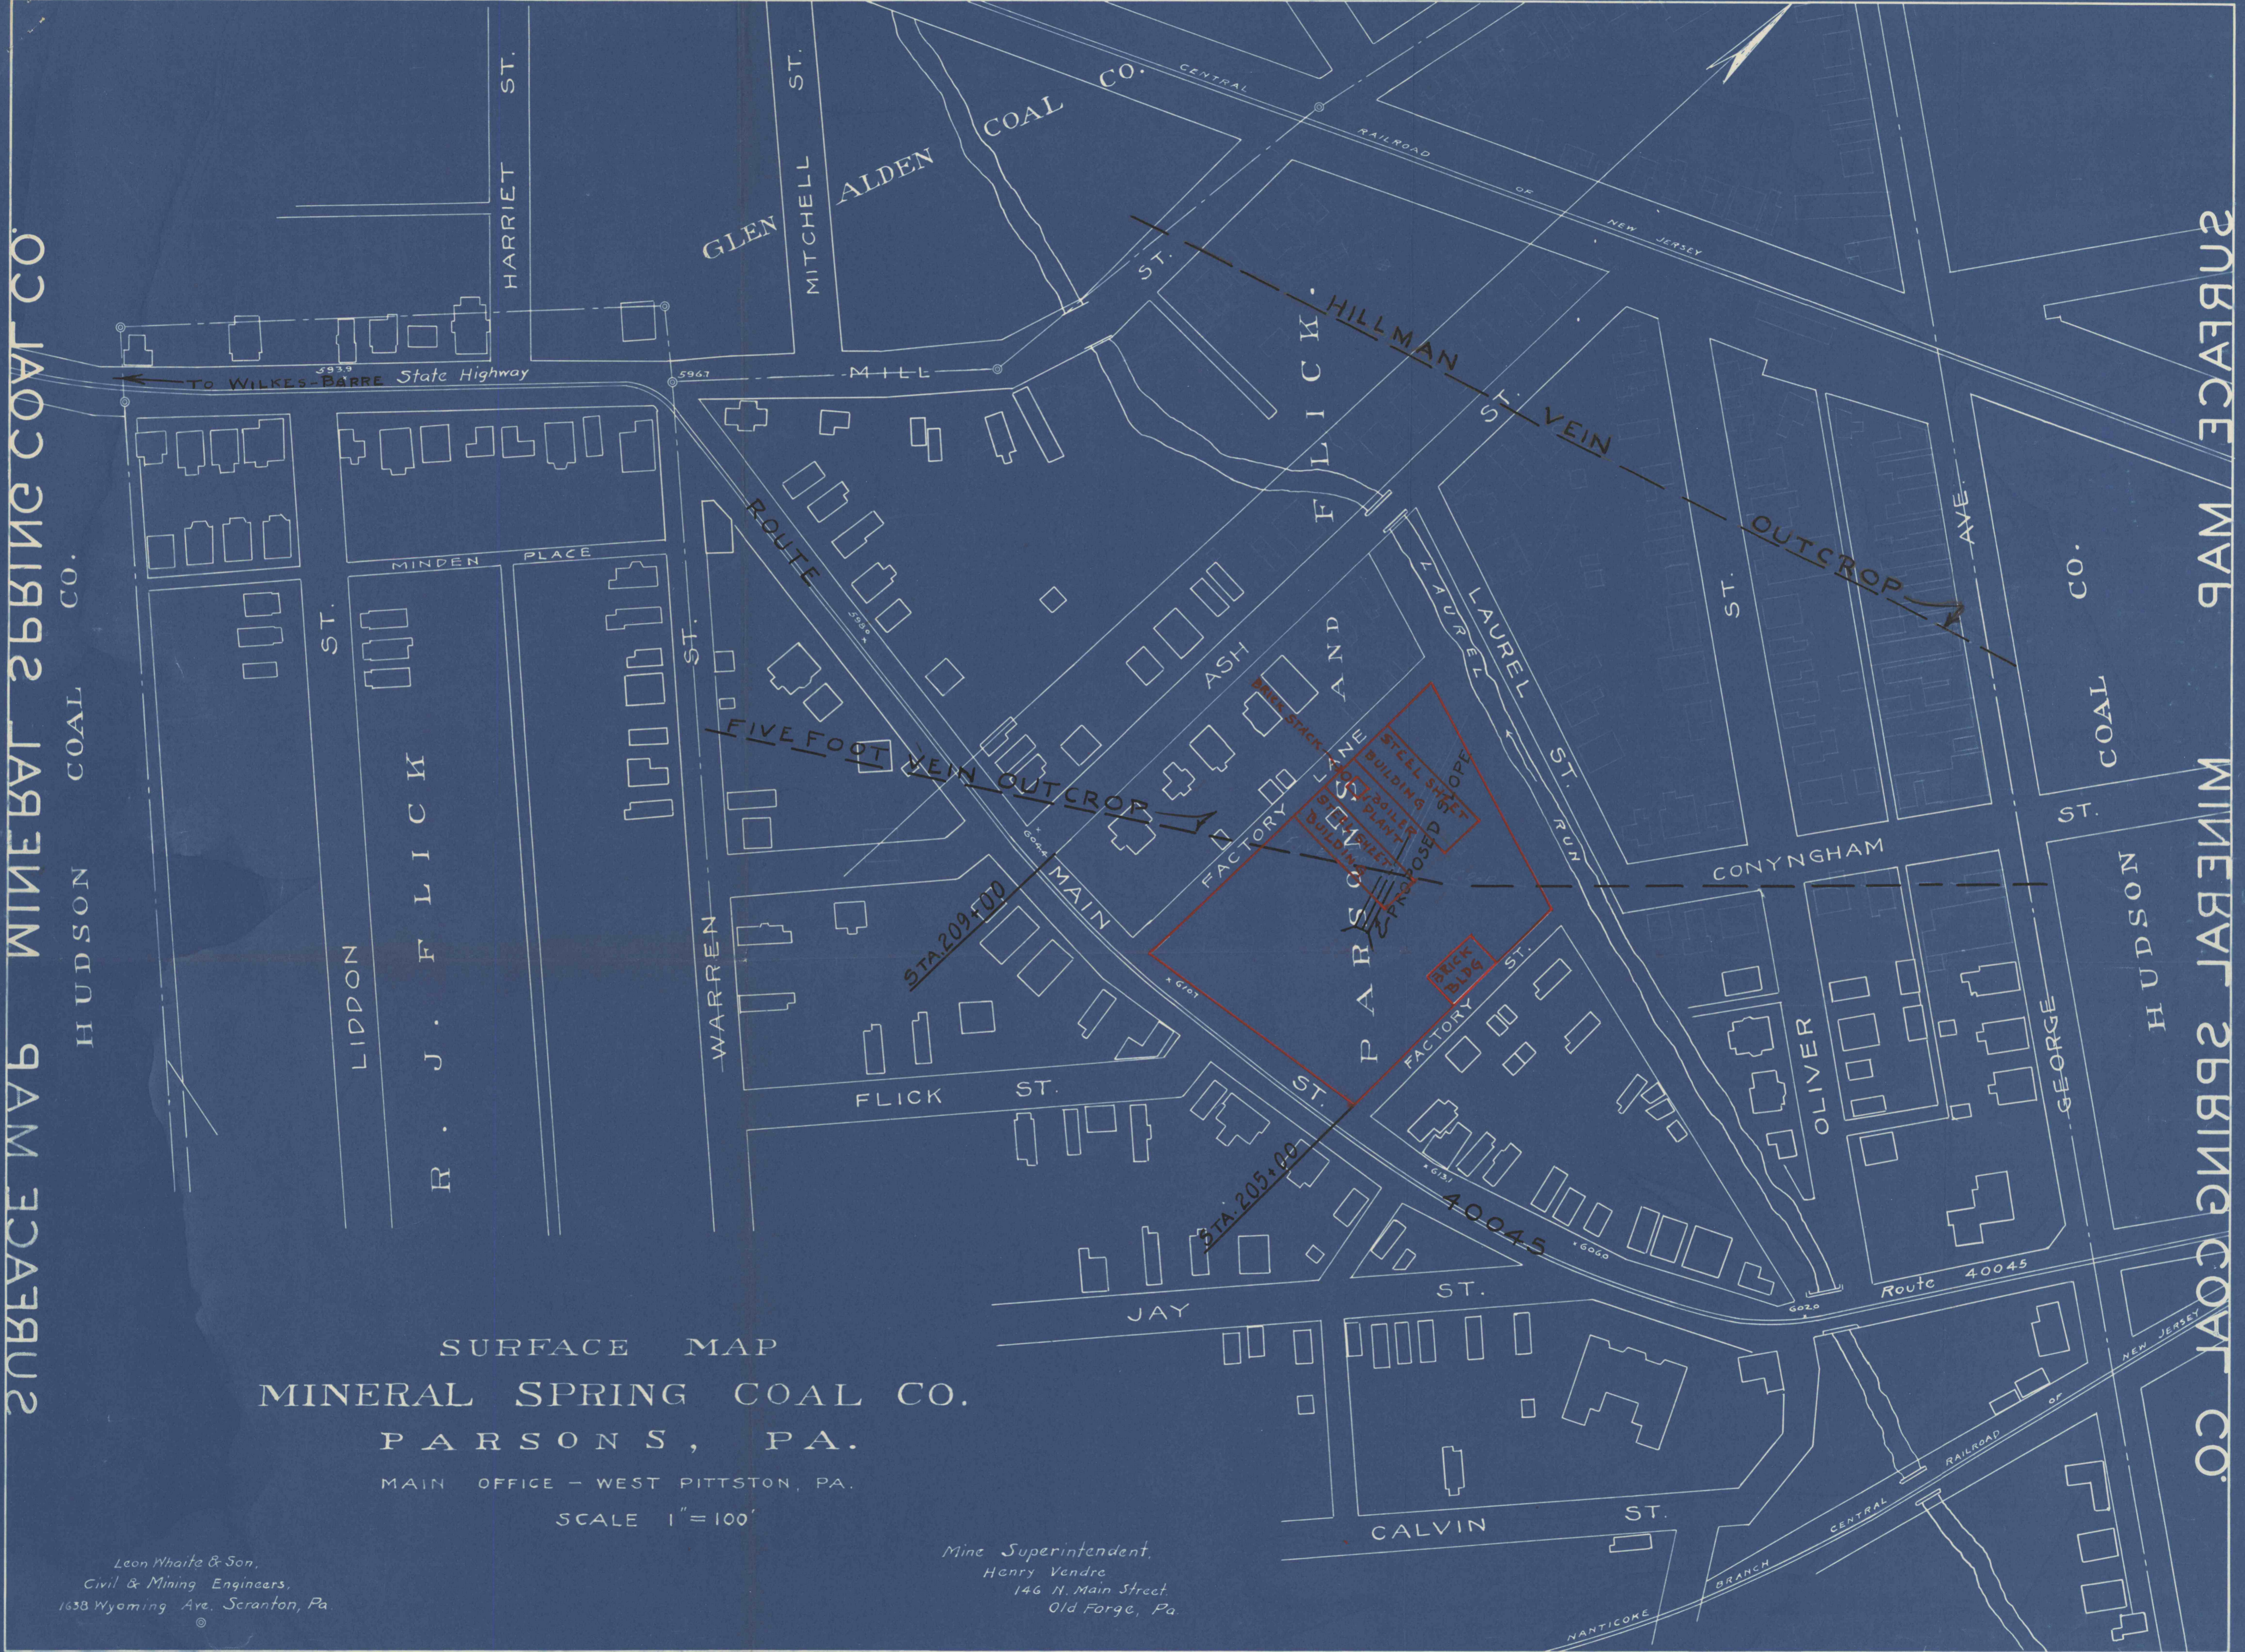

SURFACE MAP
 MINERAL SPRING COAL CO.

PARSONS, PA.


SCALE 1" = 100'

Leon White & Son,
 Civil & Mining Engineers,
 1638 Wyoming Ave., Scranton, Pa.

Mine Superintendent,
 Henry Vendre
 146 N. Main Street,
 Old Forge, Pa.