


AUTHORIZATION NO. 3681
SER. 3 1924

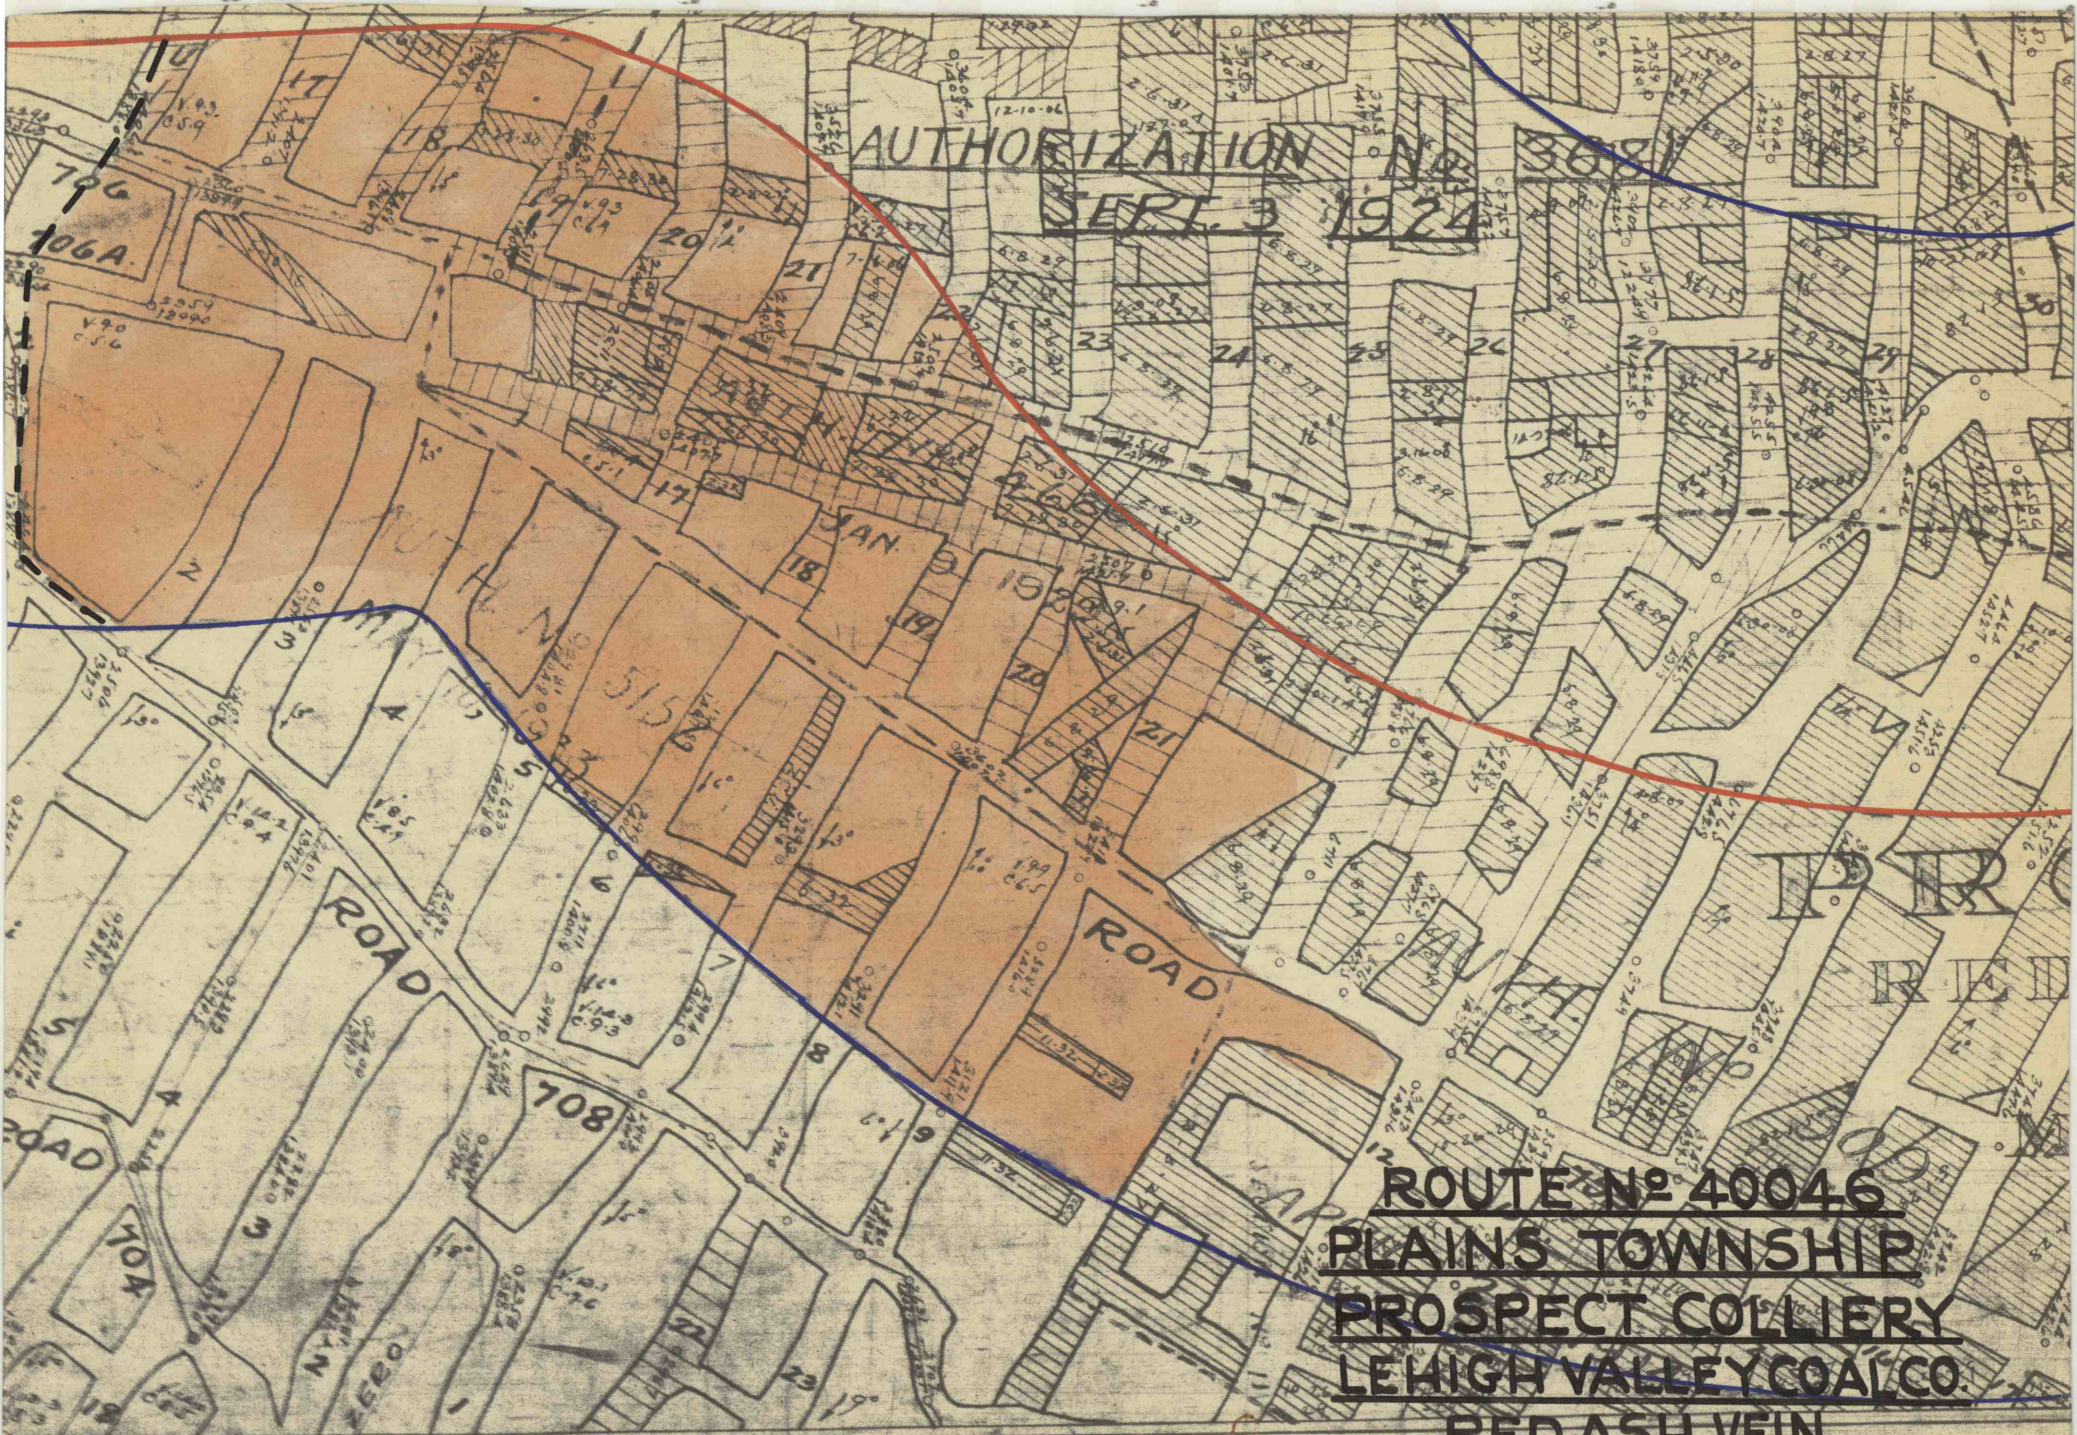

ROUTE N° 40046
PLAINS TOWNSHIP
PROSPECT COLLIERY
LEHIGH VALLEY COAL CO.
RED ASH VEIN
SCALE 1"=100'
DATUM 500' BELOW TIDE