


HENRY CC

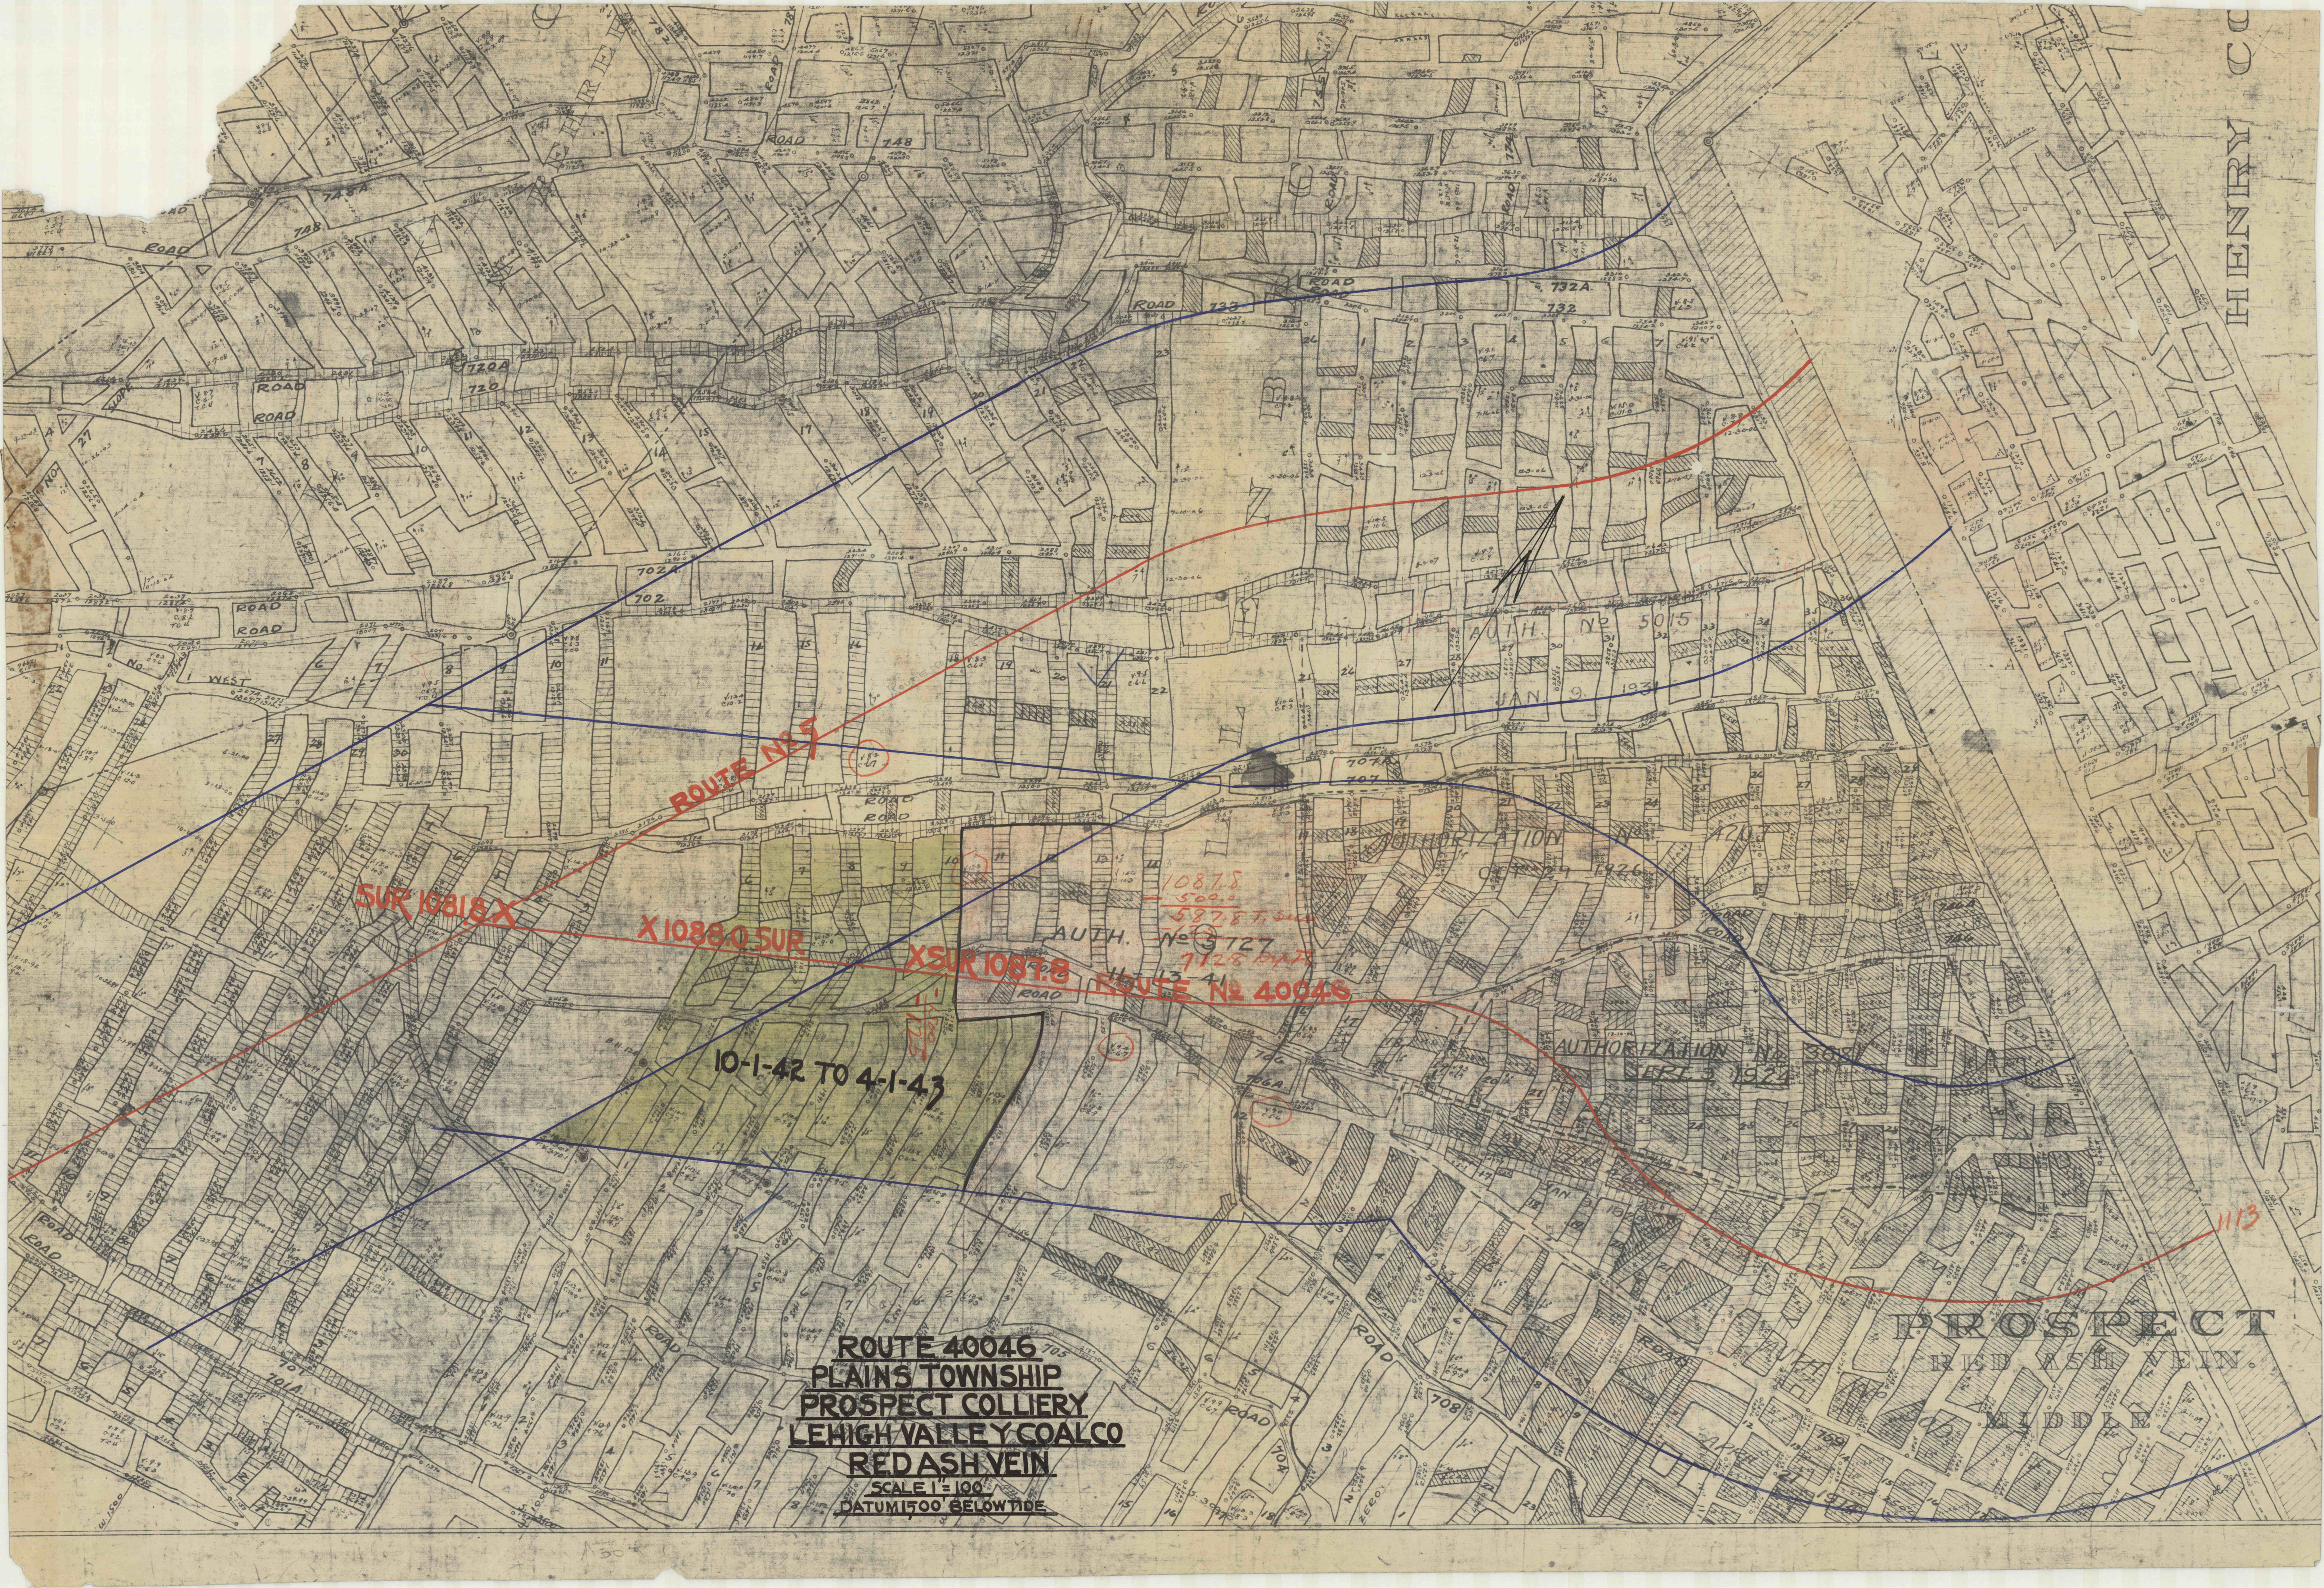

SUR 10818 X

ROUTE No 5

X 1088.0 SUR

X SUR 1087.8

ROUTE No 4004S

10-1-42 TO 4-1-43

ROUTE 4004G
PLAINS TOWNSHIP
PROSPECT COLLIERY
LEHIGH VALLEY COALCO
REDASH VEIN
SCALE 1" = 100'
DATUM 1700 BELOW TIDE

PROSPECT
REDASH VEIN
MIDDLE

1113

1087.8
500.0
597.8 T.S. SUR
712.8 PART

AUTH. No 5015
JAN 9 1931

AUTHORIZATION No 300
SERIAL 1922