


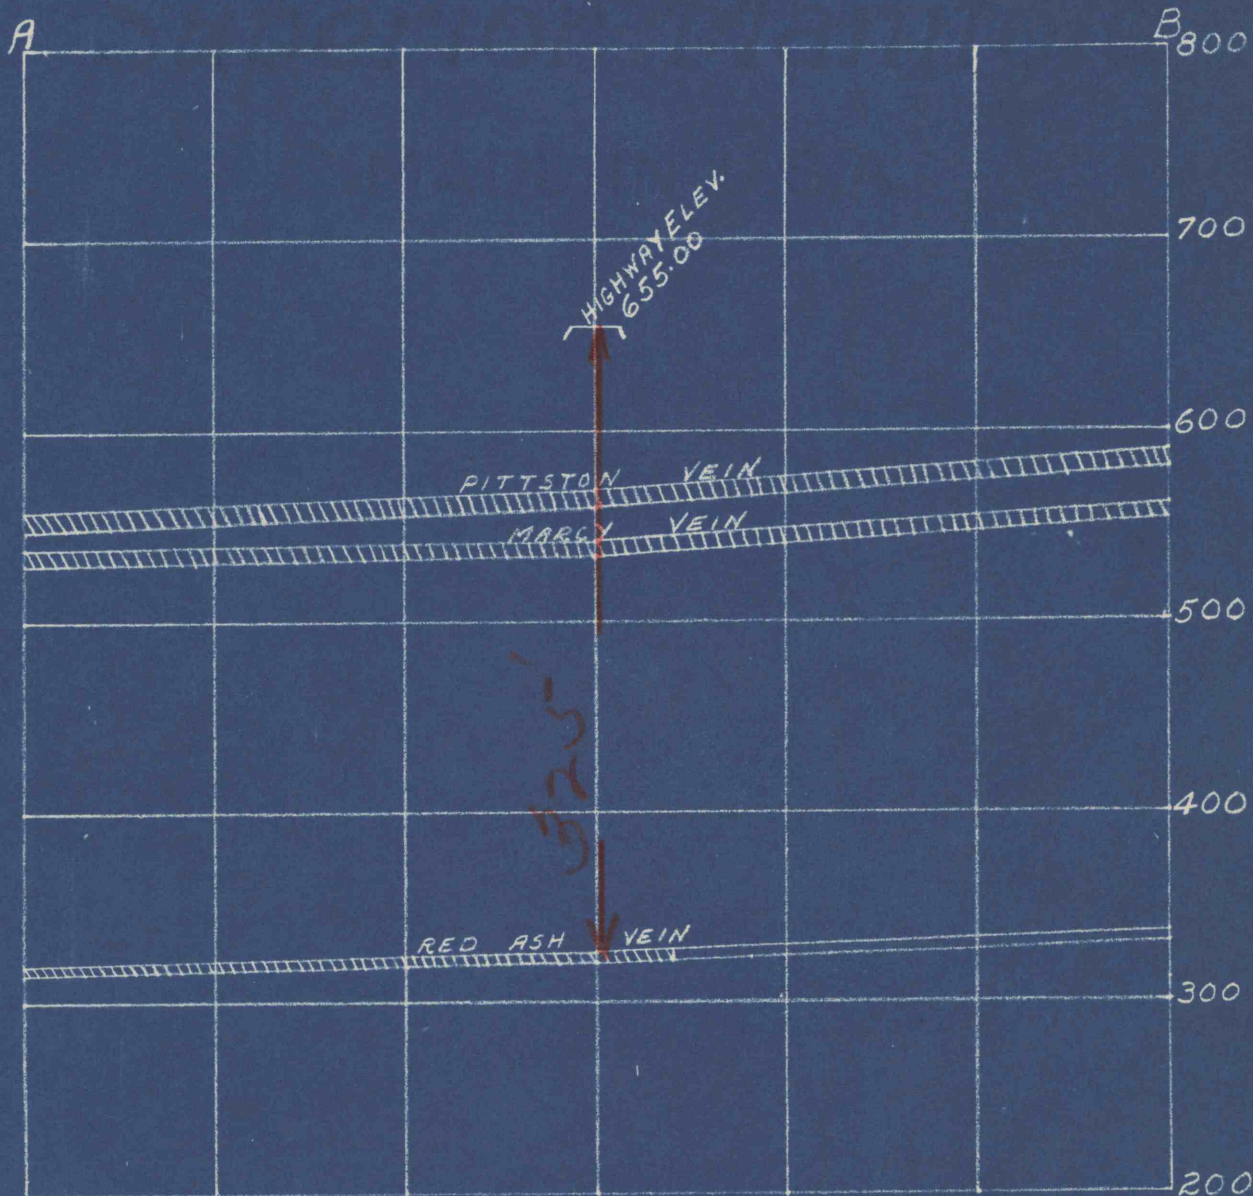

SECTION A-B



9-27-45

EWEN COLLIERY  
 No. 4 Shaft - Red Ash Vein  
 Scale 1" = 100'

Cross section of Red Ash Vein  
 underlying Leg. Route #40047,  
 Pittston City & Pittston Twp.,  
 Luzerne County, Penna.

-  First mined
-  Mining completed