



PUB. RDS. DIV. NO.	STATE	FEDERAL PROJECT	FISCAL YEAR	DISTRICT	COUNTY	ROUTE	SEC.	SHEET
2	PENNSYLVANIA			4-0	LUZERNE	40058	2	2 of 7

Plymouth and Larksville Boroughs

PENNSYLVANIA

SCALE IN MILES
10 5 0 10 20 30 40

Plymouth & Larksville Boroughs

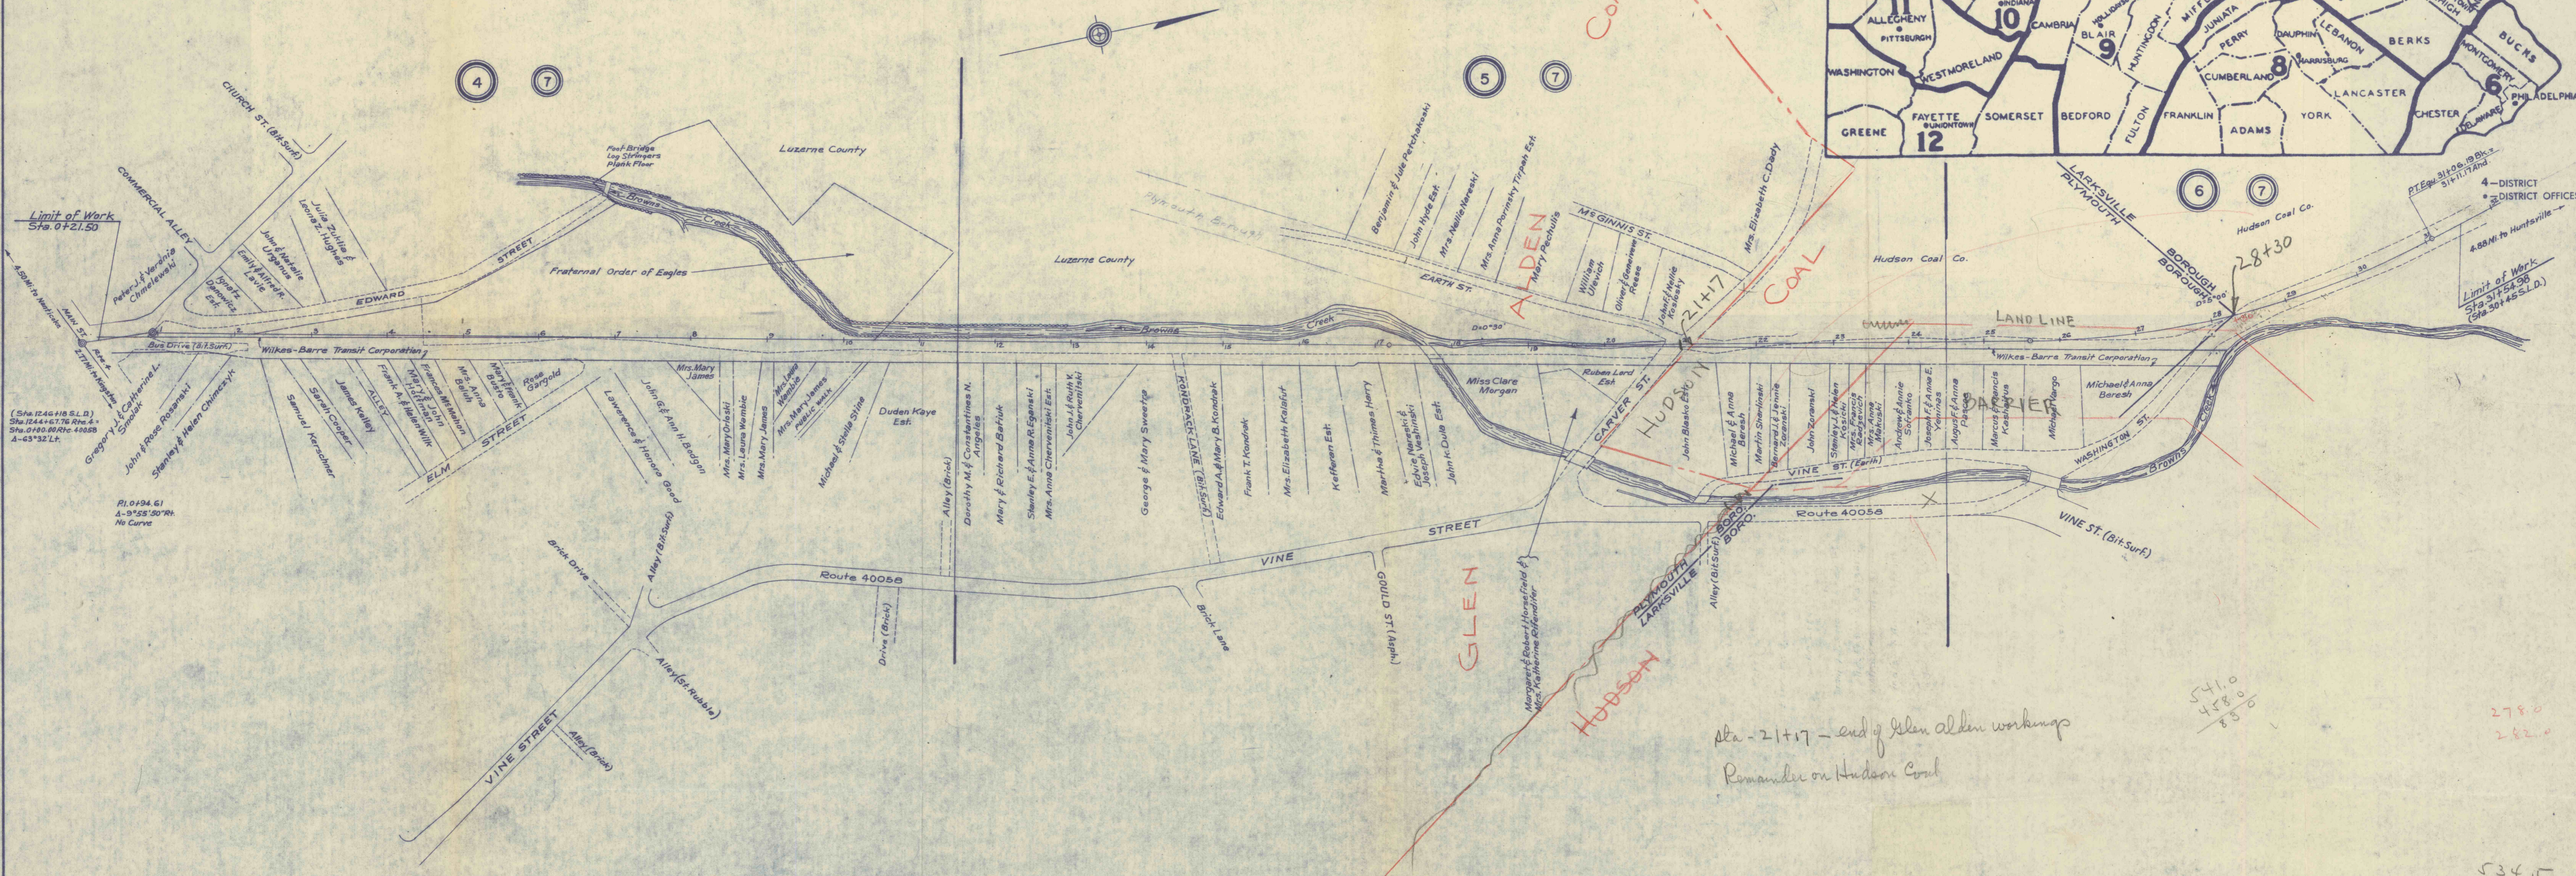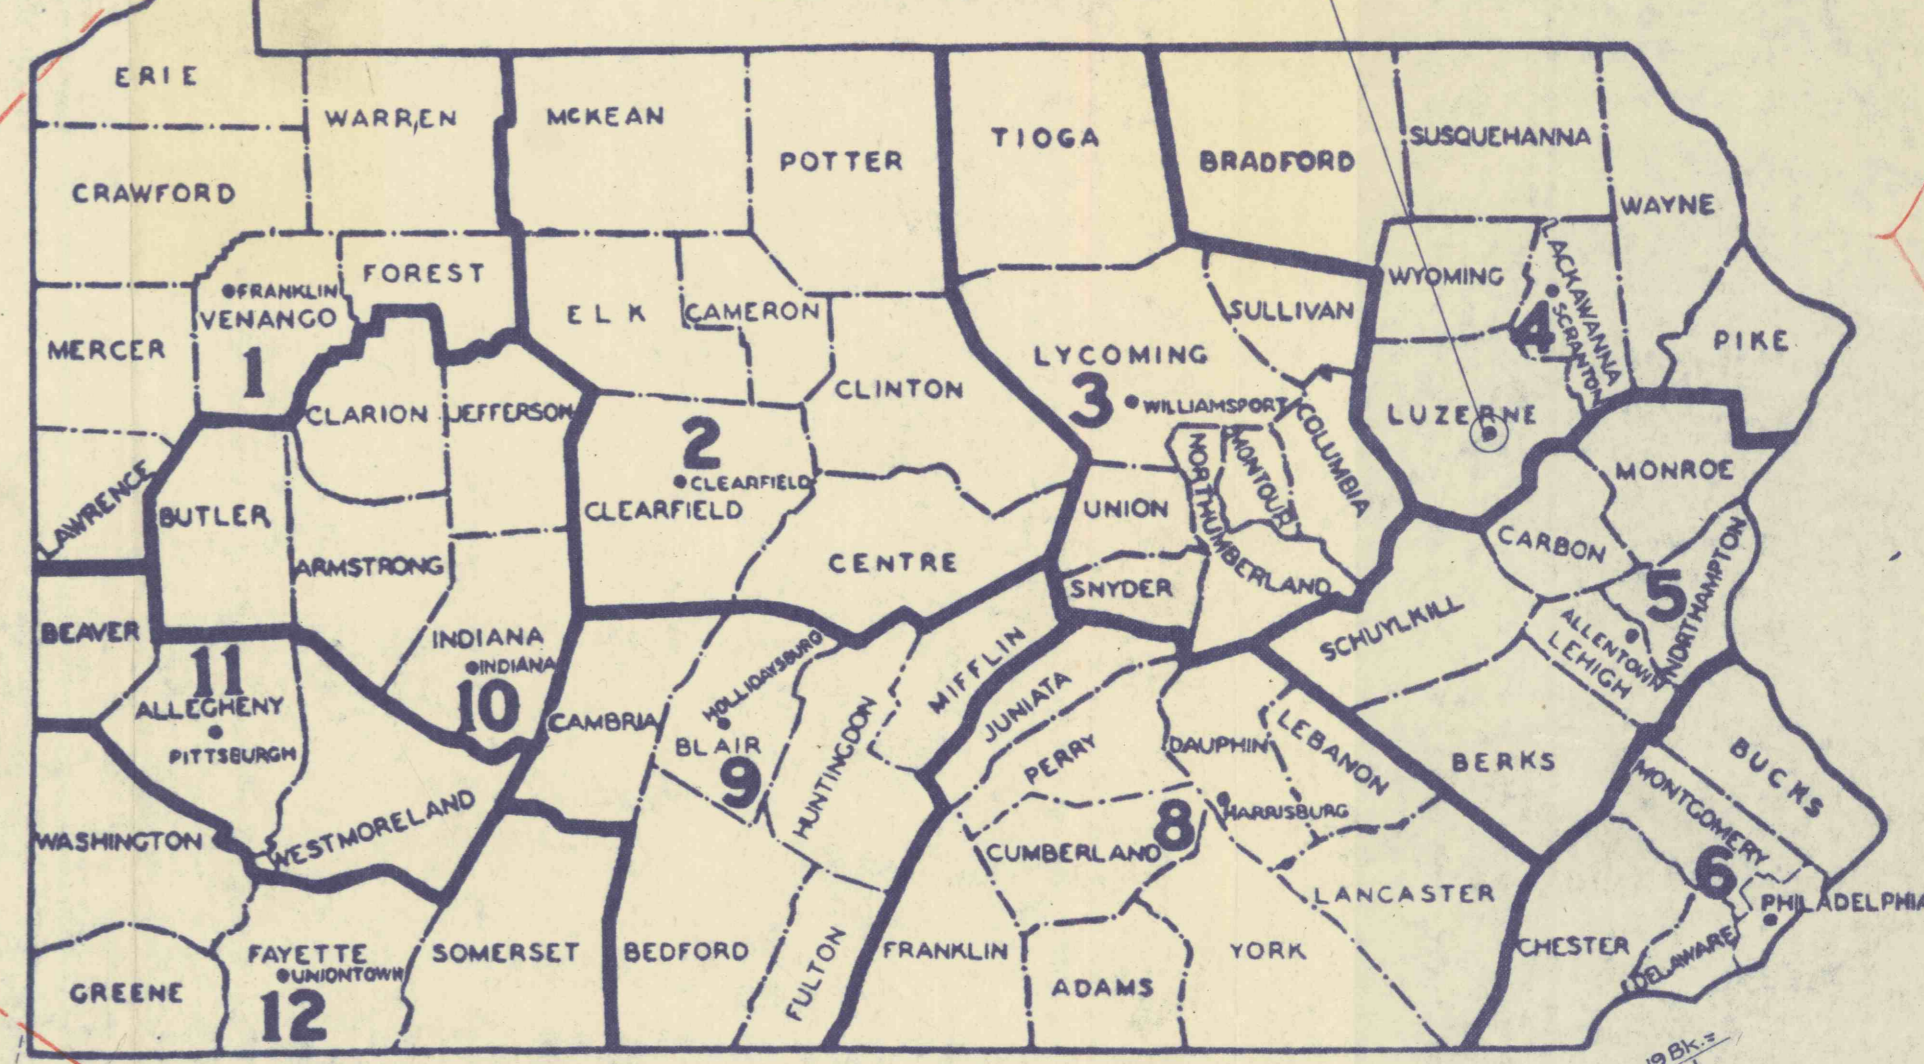

RECORD OF STATIONS OF EXISTING ROAD TYPES

Adjacent to Sta. 0+21.50	Bit Surface-Concrete Base-40' Width
Sta. 0+21.50 to Sta. 0+95.00	Bit Surface-Brick & Concrete Base-Variable Width
Sta. 0+95.00 to Sta. 2B+10.00	Relocation
Sta. 2B+10.00 to Sta. 3+15.98	Bit Surface Treated Macadam-30' Width
Adjacent to Sta. 3+15.98	Bit Surface Treated Macadam-30' Width

INDEX MAP

SCALE: 1"=100'

Sta - 2+17 - end of Helen Alden workings
Remainder on Hudson Coal

541.0
478.0
83.0

278.0
282.0

534.5
203
331.5

547.0
344
203

534.5
239.5
294.7