



FRANKLIN COAL CO.

10-1-46 TO


SUR. 1085.1

SUR. 1074

SUR. 1077.4

SUR. 1078.3

4-1-47

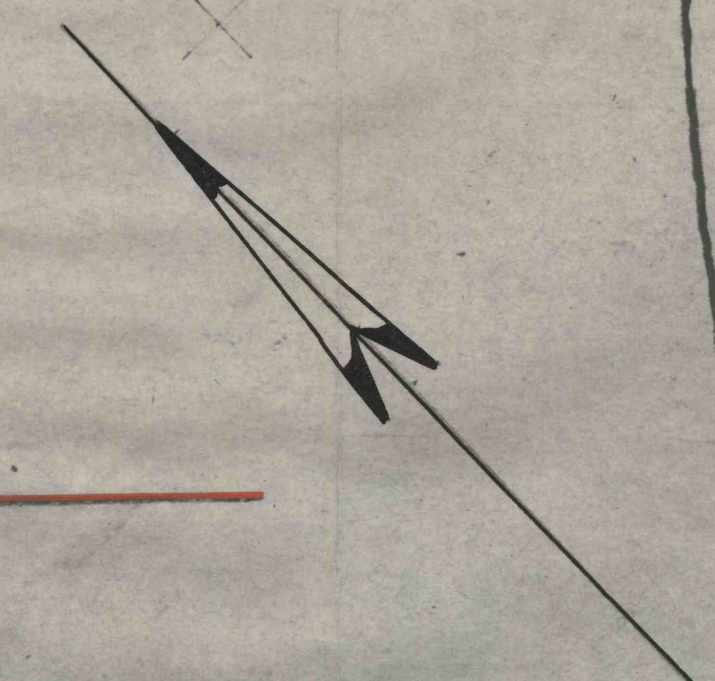

ROUTE N^o 40090
WILKES-BARRE CITY & WILKES-BARRE TWP.
FRANKLIN COLLIERY
LEHIGH VALLEY COAL COMPANY
ABBOTT VEIN
SCALE 1"=100'
DATUM 500' BELOW TIDE